

LINCOLN
Q29
6-7-72

MISSISSIPPI
BOARD OF WATER COMMISSIONERS
416 North State Street
Jackson, Mississippi 39201

WATER WELL DRILLERS LOG


CODED

7 Jul 1972 S & Water Well **CODED**
date well completed firm name county well located

| LANDOWNER: | description of formations encountered | from | to |
|---|---|---------------------|-----------------------|
| Bobby Gates | | | |
| Summit (mailing address) | Clay sand Chalky sand | 0 20 75 65 | 20 55 65 107 |
| WELL LOCATION: sec. 20 T 5 N R 8 E 6 miles NE of Summit (distance) (direction) (nearest town) | | | |
| WELL PURPOSE: (home, irrigation, municipal, industrial) | | | |
| WELL COMPLETION DATA: | | | |
| (1) diameter (inches) 4 | | | |
| (2) total depth (feet) 107 | | | |
| (3) static water level (feet) 65 below top of ground | | | |
| (4) casing (material) PL (depth) 101 | | | |
| _____ if telescope see back. (size) | | | |
| (5) screen (length) 6 (depth to top) 101 | | | |
| (size) 4 (material) PL | | | |
| (6) pump (HP) 1/2 (yield gpm) 8 | | | |
| (type power) electric | | | |
| (7) electric log (yes or no) _____ | | | |
| (organization running log) _____ | | | |
| (8) how well bottom plugged <i>used</i> | | | |
| DRILLERS REMARKS: _____ _____ _____ | CODED JUN 1 1972 MISS. Bd. of WATER COMMISSIONERS | | |

If well telescopes please sketch and show depths.

GROUND LEVEL

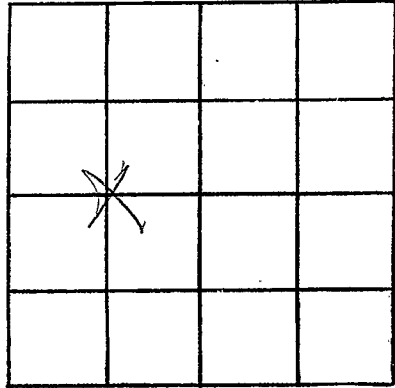

SECTION 90

Please indicate well location X.

ADDITIONAL INFORMATION

If more than one screen,
show locations of each on sketch.