

LINCOLN

Q 30

10-6-72

MISSISSIPPI BOARD OF WATER COMMISSIONERS
416 North State Street
Jackson, Mississippi 39201

WATER WELL DRILLERS LOG

CODED

10-6
date well completed

1972
firm name

Lincoln
county well located

LANDOWNER:

Willie Joe Wells

R.R. 1 Summit.
(mailing address)

WELL LOCATION:

sec. 19 T 5 N R 8 E
3 miles NE of Summit
(distance) (direction) (nearest town)

WELL PURPOSE: Home
(home, irrigation, municipal, industrial)

WELL COMPLETION DATA:

- (1) diameter (inches) 4
- (2) total depth (feet) 102
- (3) static water level (feet) 75 below top of ground.
- (4) casing plastic 94 (material) (depth),
4 (size) if telescope see back.
- (5) screen 8 94 (length) (depth to top)
4 (size) plastic (material)
- (6) pump 1/2 70 (HP) (yield gpm)
elec (type power)
- (7) electric log no (yes or no)
(organization running log)
- (8) how well bottom plugged Wood

description of formations encountered

from to

Red clay	0	20
Red gravel	20	35
White clay	35	80
Thin sand	80	90
Coarse sand & gravel	90	102

CODED


OCT 17 1972

DRILLERS REMARKS:

MISS. B.L.
WATERS CONTROL

If well telescopes please sketch and show depths.

GROUND LEVEL

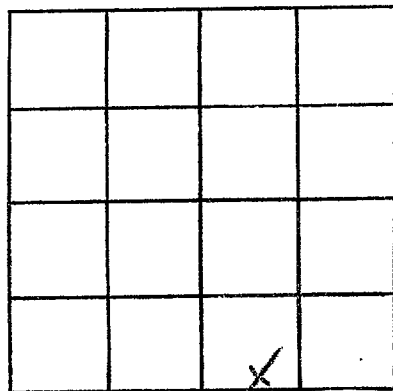

SECTION 19

Please indicate well location X.

ADDITIONAL INFORMATION

If more than one screen, show locations of each on sketch.