

LINCOLN

Q 31

9-27-72

MISSISSIPPI BOARD OF WATER COMMISSIONERS 416 North State Street Jackson, Mississippi 39201

CODED

WATER WELL DRILLERS LOG

9-27-72 date well completed

1972 J. C. ... firm name

Lincoln county well located

LANDOWNER:

Alfred Fom

(mailing address)

WELL LOCATION:

sec 31 T 5 N R 8 E 5 miles N of ... (distance) (direction) (nearest town)

WELL PURPOSE:

(home, irrigation, municipal, industrial)

WELL COMPLETION DATA:

- (1) diameter (inches) 4
(2) total depth (feet) 103
(3) static water level (feet) 80 below top of ground
(4) casing (material) PL (depth) 97
(5) screen (length) 6 (depth to top) 97
(6) pump (HP) 1 (yield gpm) 12
(7) electric log (yes or no)

CODED

(organization running log)

(8) how well bottom plugged wood

DRILLERS REMARKS:

description of formations encountered

from

to


clay 0 25
cherty clay 25 65
sand 65 60
clay sand 60 75
sand (bed) 75 103

SEP 24 1972

MISS. Bd. OF WATER COMM

If well telescopes please sketch and show depths.

GROUND LEVEL

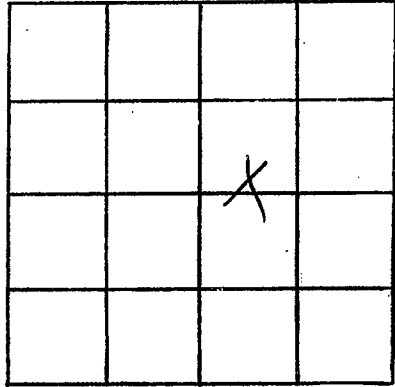

SECTION 31

Please indicate well location X.

ADDITIONAL INFORMATION

If more than one screen,
show locations of each on sketch.