

LINCOLN

Q 32

11-29-72

MISSISSIPPI  
BOARD OF WATER COMMISSIONERS  
416 North State Street  
Jackson, Mississippi 39201

## WATER WELL DRILLERS LOG

11-29  
date well completed

19 72

firm name

Lincoln  
county well located

## LANDOWNER:

Charles Lanning

R.R. Brune Clitto

(mailing address)

## description of formations encountered

from

to

Red clay

6

20

Red sand

20

90

Red gravel

90

105

Cannon Point gravel

105

120

## WELL LOCATION:

sec. 21 T. 5 N R. 8 E

12 miles NE of Brant  
(distance) (direction) (nearest town)

## WELL PURPOSE:

(home, irrigation, municipal, industrial)

## WELL COMPLETION DATA:

- (1) diameter (inches) 4  
(2) total depth (feet) 120  
(3) static water level (feet) 80 below  
top of ground.

- (4) casing 112  
(material) (depth)

4 if telescope see back.  
(size)

- (5) screen 112  
(length) (depth to top)

4  
(size) (material)

- (6) pump 1 1/2 10  
(HP) (yield gpm)

40  
(type power)

- (7) electric log 74  
(yes or no)

(organization running log)

- (8) how well bottom plugged Wood peg

DRILLERS REMARKS:


DEC 7 1972

OD, US

STANDARD

If well telescopes please  
sketch and show depths.

GROUND LEVEL

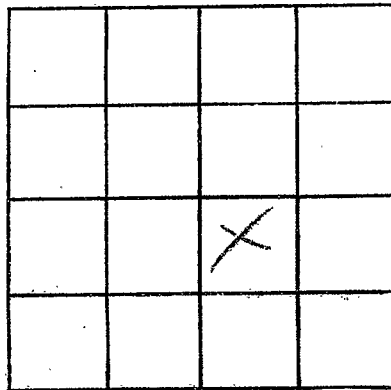

SECTION 21

Please indicate well location X.

ADDITIONAL INFORMATION

If more than one screen,  
show locations of each on sketch.