

LINCOLN
033
9-73

MISSISSIPPI
 BOARD OF WATER COMMISSIONERS
 416 North State Street
 Jackson, Mississippi 39201

CODED

WATER WELL DRILLERS LOG

Sept 1973 Greenwater Well Cont. Lincoln
 date well completed firm name county well located

LANDOWNER: Eugene Stephens
Bogue Chitto, Miss
Rt 1
 (mailing address)

description of formations encountered
Calrouelle
 from 0 to 140

WELL LOCATION:
 sec. 9 T. 5 N. R. 8 E
5 miles SE of Boguechitto
 (distance) (direction) (nearest town)

WELL PURPOSE: home
 (home, irrigation, municipal, industrial)

WELL COMPLETION DATA:
 (1) diameter (inches) 6"
 (2) total depth (feet) 125
 (3) static water level (feet) 75 below above top of ground.
 (4) casing PVC, 119,
 (material) (depth)
4" If telescope see back.
 (size)
 (5) screen 6', 119
 (length) (depth to top)
010, PVC
 (size) (material)
 (6) pump did not install
 (HP) (yield gpm)
 (type power)
 (7) electric log no
 (yes or no)
 (organization running log)
 (8) how well bottom plugged wood


CODED

DRILLERS REMARKS:

OCT 25 1973

If well telescopes please sketch and show depths.

GROUND LEVEL

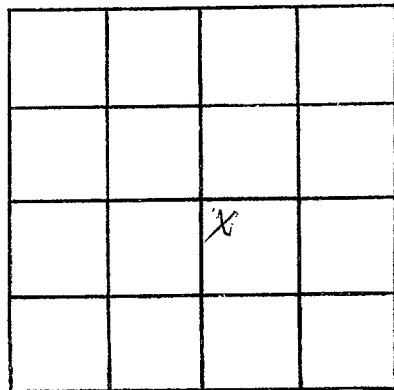

SECTION 9

Please indicate well location X.

ADDITIONAL INFORMATION

If more than one screen,
show locations of each on sketch.