

LINCOLN
Q 34
10-18-73

MISSISSIPPI
BOARD OF WATER COMMISSIONERS
416 North State Street
Jackson, Mississippi 39201

CODED

WATER WELL DRILLERS LOG

Oct. 18 1973 Greenwater Well Co. Lincoln
date well completed firm name county well located

LANDOWNER: 1
Thomas Bessouette
Boque Chitto Miss
(mailing address)

description of formations encountered
Citronelle from 0 to 110

WELL LOCATION:
sec. 5 T. 15 N. R. 8 E
3 miles E. of Boque Chitto
(distance) (direction) (nearest town)

WELL PURPOSE: Home
(home, irrigation, municipal, industrial)

- WELL COMPLETION DATA:
- (1) diameter (inches) 6"
 - (2) total depth (feet) 91'
 - (3) static water level (feet) 55' below top of ground.
 - (4) casing PVC, 85'
(material) (depth)
4" if telescope see back.
(size)
 - (5) screen 6', 85'
(length) (depth to top)
.010, PVC
(size) (material)
 - (6) pump did not
(HP) (yield gpm)
install
(type power)
 - (7) electric log no
(yes or no)

(organization running log)
 - (8) how well bottom plugged wood

CODED


OCT 25 1973

DRILLERS REMARKS:

MISS. DIV. OF
WATER CONTROL
JACKSON, MISSISSIPPI

If well telescopes please sketch and show depths.

GROUND LEVEL

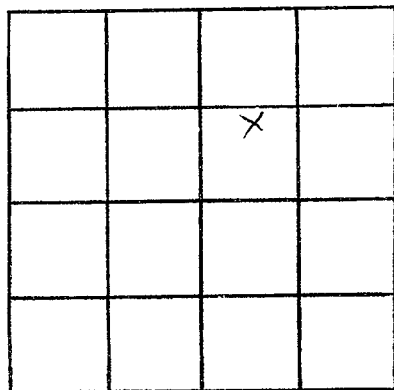

SECTION 5

Please indicate well location X.

ADDITIONAL INFORMATION

If more than one screen,
show locations of each on sketch.