

LINCOLN
 Q 35
 9-26-73

MISSISSIPPI
 BOARD OF WATER COMMISSIONERS
 416 North State Street
 Jackson, Mississippi 39201

CODED

WATER WELL DRILLERS LOG

9-26
 date well completed

19 23 *Edmund Bell Lee*
 firm name

Lincoln
 county well located

LANDOWNER:
Louis Jordan
R.R. Bayne Clitto
 (mailing address)

description of formations encountered	from	to
	<i>Red Clay</i>	<i>0</i>
<i>Red gravel</i>	<i>20</i>	<i>90</i>
<i>Coarse Sand & gravel</i>	<i>90</i>	<i>102</i>

WELL LOCATION:
 sec 25 T 5 N R 8 E
2 miles N of Shalburne
 (distance) (direction) (nearest town)

WELL PURPOSE:
 (home, irrigation, municipal, industrial) Home

- WELL COMPLETION DATA:
- (1) diameter (inches) 4
 - (2) total depth (feet) 102
 - (3) static water level (feet) 65 below above top of ground.
 - (4) casing plastic 94
 (material) (depth)
4 if telescope see back.
 (size)
 - (5) screen 8 94
 (length) (depth to top)
4 plastic
 (size) (material)
 - (6) pump 1/2 10
 (HP) (yield gpm)
ela
 (type power)
 - (7) electric log no
 (yes or no)
 - (organization running log)
 - (8) how well bottom plugged plugged

CODED


OCT 9 1973

DRILLERS REMARKS:

MISS. BO. OF
 WATER COMMISSIONERS

If well telescopes please sketch and show depths.

GROUND LEVEL

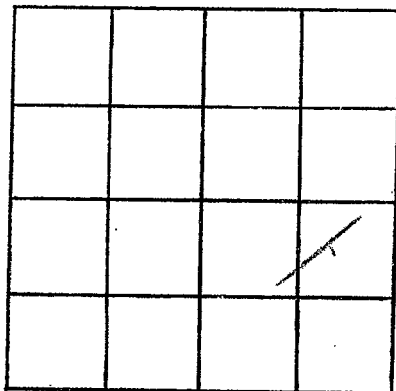

SECTION 35

Please indicate well location X.

ADDITIONAL INFORMATION

If more than one screen, show locations of each on sketch.