

LINCOLN
① 36
10-12-73

MISSISSIPPI
BOARD OF WATER COMMISSIONERS
416 North State Street
Jackson, Mississippi 39201

CODED

WATER WELL DRILLERS LOG

17 Oct 1973 J.T. Brumpton & Son Lincoln
date well completed firm name county well located

LANDOWNER:
Edward Lee bathin
Angus P. Hutto
(mailing address)

WELL LOCATION:
sec. 5 T. 5N R. 8 E
3 miles E of B.C.
(distance) (direction) (nearest town)

WELL PURPOSE:
(home, irrigation, municipal, industrial)

WELL COMPLETION DATA:
(1) diameter (inches) 4
(2) total depth (feet) 94
(3) static water level (feet) 00 below
top of ground.
(4) casing PI 98
(material) (depth)
(size) if telescope see back.
(5) screen 6 88
(length) (depth to top)
4 A
(size) (material)
(6) pump 1/2 5
(HP) (yield gpm)
split
(type power)
(7) electric log _____
(yes or no)
(organization running log)
(8) how well bottom plugged wood

description of formations encountered	from	to
	clay	0
chert	20	45
sand chert	45	60
sand	60	94

CODED


DRILLERS REMARKS:

DEC 6 1973

MISSISSIPPI
WATER BOARD

If well telescopes please sketch and show depths.

GROUND LEVEL

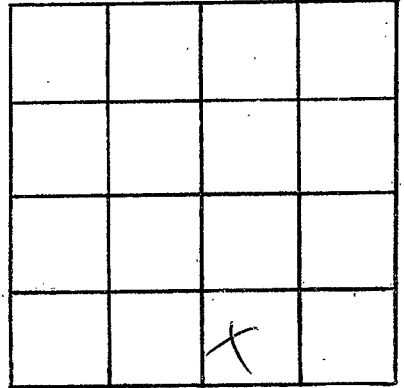

SECTION 5

Please indicate well location X.

ADDITIONAL INFORMATION

If more than one screen, show locations of each on sketch.