

LINCOLN
Q37
12-4-73

MISSISSIPPI
BOARD OF WATER COMMISSIONERS
416 North State Street
Jackson, Mississippi 39201

WATER WELL DRILLERS LOG **CODED**

12-4 1973 *Fitzgerald* LINCOLN
date well completed firm name county well located

LANDOWNER:

Pat Harrell Jr.
RR. Ruth Miss.
(mailing address)

description of formations encountered

red clay
red soil
Coarse sand & gravel

from to

0 20
20 70
40 75

WELL LOCATION:

sec. *25* T. *5* N. R. *8* E.
S. W.
4 miles *SW* of *Ruth*
(distance) (direction) (nearest town)

WELL PURPOSE:

(home, irrigation, municipal, industrial)

WELL COMPLETION DATA:

- (1) diameter (inches): *4*
- (2) total depth (feet): *75*
- (3) static water level (feet): *60* below top of ground.
- (4) casing: *plastic* *67*,
(material) (depth)
4 if telescope see back.
(size)
- (5) screen: *8* *67*
(length) (depth to top)
4 *plastic*
(size) (material)
- (6) pump: *1/2* *10*
(HP) (yield gpm)
elec
(type power)
- (7) electric log: *no*
(yes or no)
- (organization running log)

CODED

(8) how well bottom plugged *covered by*


JAN 28 1974

DRILLERS REMARKS:

MISS. Bd. OF WATER COMM

If well telescopes please
sketch and show depths.

GROUND LEVEL

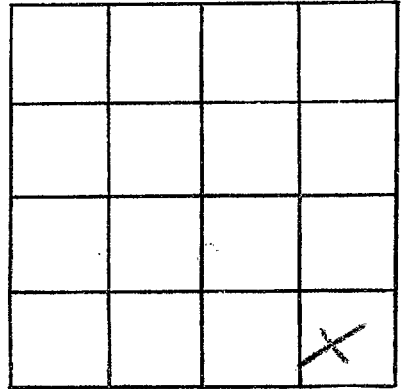

SECTION 25

Please indicate well location X.

ADDITIONAL INFORMATION

If more than one screen,
show locations of each on sketch.