

**LINCOLN**  
 Q38  
 1-4-74

MISSISSIPPI  
 BOARD OF WATER COMMISSIONERS  
 416 North State Street  
 Jackson, Mississippi 39201 **CODED**

**WATER WELL DRILLERS LOG**

~~Jan 4 1974~~  
~~Dec 28~~ 1973 Green Water Well Lincoln  
 date well completed firm name county well located

LANDOWNER: Stanley Jordan  
Route 2  
Bogue Chitto Miss  
 (mailing address)

description of formations encountered	from	to
	<u>Citronelle</u>	<u>0</u>

WELL LOCATION:  
 sec. 25 T. 5 N. R. 8 E  
5 miles E of Bogue Chitto  
 (distance) (direction) (nearest town)

WELL PURPOSE: home  
 (home, irrigation, municipal, industrial)

**CODED**


- WELL COMPLETION DATA:
- (1) diameter (inches) 6"
  - (2) total depth (feet) 135 ft
  - (3) static water level (feet) 65 below above top of ground.
  - (4) casing PVC, 129'  
 (material) (depth)  
4" if telescope see back.  
 (size)
  - (5) screen 6', 129'  
 (length) (depth to top)  
1010, PVC  
 (size) (material)
  - (6) pump 1/2 hp 7  
 (HP) (yield gpm)  
electric  
 (type power)
  - (7) electric log no  
 (yes or no)
  - (organization running log)
  - (8) how well bottom plugged wood

DRILLERS REMARKS:

APR 3 1974  
 MISS. D. OF WATER

If well telescopes please sketch and show depths.

GROUND LEVEL

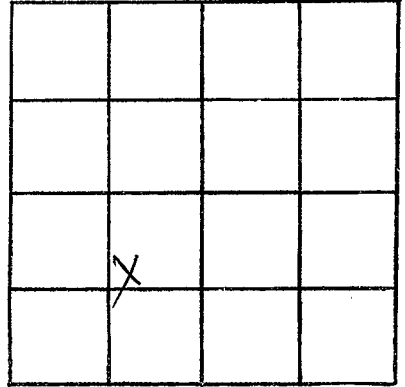

SECTION 25

Please indicate well location X.

ADDITIONAL INFORMATION

If more than one screen,  
show locations of each on sketch.