

LINCOLN
 Q 39
 10/16/74

MISSISSIPPI
 BOARD OF WATER COMMISSIONERS
 416 North State Street
 Jackson, Mississippi 39201

CODED

WATER WELL DRILLERS LOG

10 Oct
 date well completed

1974 J.T. Conroy & Son
 firm name

Lincoln
 county well located

LANDOWNER:
 Bill McClelland
 Summit
 (mailing address)

description of formations encountered	from	to
clay	0	25
cherty sand	25	40
sand	40	80
cherty	80	120
sand	120	160

WELL LOCATION:
 sec 30 T 5 N R 8 E
 S W
 5 miles N of Summit
 (distance) (direction) (nearest town)

WELL PURPOSE:
 (home, irrigation, municipal, industrial)

CODED

WELL COMPLETION DATA:

(1) diameter (inches) 4

(2) total depth (feet) 163

(3) static water level (feet) 80 below above top of ground.

(4) casing 8" 157' (material) (depth)

(size) If telescope see back.

(5) screen 6" 157' (length) (depth to top)

(size) (material)

(6) pump 1/2 HP 8 (yield gpm)

(type power) electric

(7) electric log (yes or no)

(organization running log)

(8) how well bottom plugged wood


RECEIVED
 DEC 2 1974

DRILLERS REMARKS:

MISS. BD. OF WATER COMM.

If well telescopes please sketch and show depths.

GROUND LEVEL

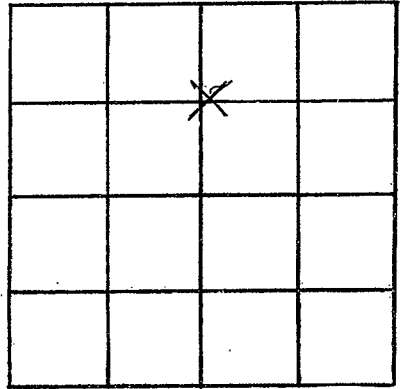

SECTION 30

Please indicate well location X.

ADDITIONAL INFORMATION

If more than one screen, show locations of each on sketch.