

LINCOLN
Q 40
1-28-75

MISSISSIPPI
BOARD OF WATER COMMISSIONERS
 416 North State Street
 Jackson, Mississippi 39201

CODED

WATER WELL DRILLERS LOG

28 Jan 1975

J.T. Corbett

Lincoln

date well completed

firm name

county well located

LANDOWNER:

Mark's Creek Church

Summit

(mailing address)

description of formations encountered

from

to

clay
 sand

25 25
 25 87

WELL LOCATION:

sec. 30 T 5 N

R 7 E
 SW

5 miles N

(direction)

Summit

WELL PURPOSE:

(home, irrigation, municipal, industrial)

WELL COMPLETION DATA:

- (1) diameter (inches) 4
- (2) total depth (feet) 187
- (3) static water level (feet) 21 below top of ground.
- (4) casing pl 81
 (material) (depth)
 (size) if telescope see back.
- (5) screen 6 81
 (length) (depth to top)
4 pl
 (size) (material)
- (6) pump 1/2 5
 (HP) (yield gpm)
 (type power)
- (7) electric log
 (yes or no)
 (organization running log)
- (8) how well bottom plugged well


DRILLERS REMARKS:

RECEIVED
REC'D

APR 7 1975

If well telescopes please sketch and show depths.

GROUND LEVEL

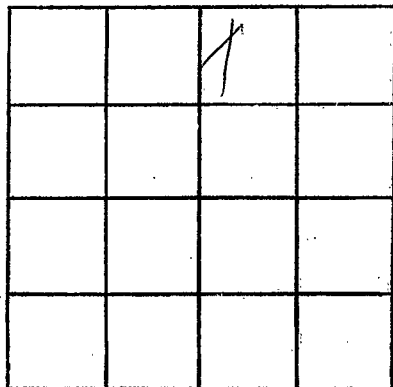

SECTION 30

Please indicate well location X.

ADDITIONAL INFORMATION

If more than one screen, show locations of each on sketch.