


Lincoln
Q 41
7-7-75

MISSISSIPPI
 BOARD OF WATER COMMISSIONERS
 416 North State Street
 Jackson, Mississippi 39201

CODED


WATER WELL DRILLERS LOG

July 7 1975 Grem Water Well Cont. Lincoln
 date well completed firm name county well located

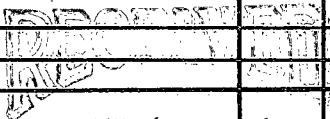LANDOWNER	description of formations encountered	from	to
Jimmy Price Route 3, Box 242 Brookhaven, Miss. (mailing address)	Citronelle	1	130
WELL LOCATION: sec. <u>9</u> T. <u>5</u> <u>N</u> R. <u>8</u> <u>E</u> ¹³⁰ <u>3</u> miles <u>SE</u> of <u>Bogue Chitto</u> (distance) (direction) (nearest town)			
WELL PURPOSE: <u>home</u> (home, irrigation, municipal, industrial)			
WELL COMPLETION DATA:			
(1) diameter (inches) <u>6"</u>			
(2) total depth (feet) <u>130</u>			
(3) static water level (feet) <u>80</u> ^{below} above top of ground.			
(4) casing <u>PVC</u> <u>124</u> (material) (depth) <u>4"</u> if telescope see back. (size)			
(5) screen <u>6'</u> <u>124'</u> (length) (depth to top) <u>.010</u> <u>PVC</u> (size) (material)			
(6) pump <u>did not install</u> (HP) (yield gpm) (type power)			
(7) electric log <u>no</u> (yes or no) (organization running log)			
(8) how well bottom plugged <u>wood</u>			
DRILLERS REMARKS:			
 SEP 18 1975			
MISS. Bd. OF WATER COM.			

If well telescopes please sketch and show depths.

GROUND LEVEL

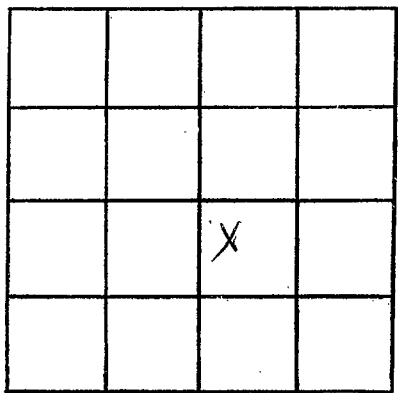

SECTION 9

Please indicate well location X.

ADDITIONAL INFORMATION

Lined area for additional information.

If more than one screen, show locations of each on sketch.