

Lincoln  
 Q-42  
 7/21/80

MISSISSIPPI  
 BOARD OF WATER COMMISSIONERS  
 416 North State Street  
 Jackson, Mississippi 39201

CODED

WATER WELL DRILLERS LOG

7-21-80 *Armer Drilling Lincoln*  
 date well completed firm name county well located

LANDOWNER:  
*R. E. Williams*  
*P. O. Box 698*  
*Natches, MS 39120*  
 (mailing address)

WELL LOCATION: *770' N + 2092' W*  
 T-50 N R-80 E of  
*no road* *1/2* miles *Dogwood* *3/4* miles  
*Rawl* (distance) (direction) (town)

description of formations encountered	from	to
<i>clay</i>	<i>0</i>	<i>15</i>
<i>sand, pea gravel</i>	<i>15</i>	<i>105</i>
<i>clay</i>	<i>105</i>	<i>335</i>
<i>sand &amp; clay</i>	<i>335</i>	<i>357</i>
<i>clay</i>	<i>357</i>	<i>403</i>
<i>sand, breaker of clay</i>	<i>403</i>	<i>483</i>
<i>clay</i>	<i>483</i>	<i>615</i>

WELL PURPOSE: *oil field supply*  
 (home, irrigation, municipal, industrial)

WELL COMPLETION DATA:

(1) diameter (inches) *3"*

(2) total depth (feet) *615'*

(3) static water level (feet) *150'* <sup>below</sup> above top of ground.

(4) casing *steel, 483'*  
 (material) (depth)  
*3"* if telescope see back.  
 (size)

(5) screen *42'* *441'*  
 (length) (depth to top)  
*3" perforated*  
 (size) (material)

(6) pump *55*  
 (HP) (yield gpm)  
*ac*  
 (type power)

(7) electric log   
 (yes or no)  
 (organization running log)

(8) how well bottom plugged *well ramp*

DRILLERS REMARKS:


DEPT. OF NATURAL RESOURCES  
 BUREAU OF LAND & WATER RESOURCES

JUL 28 1980

RECEIVED

If well telescopes please sketch and show depths.

GROUND LEVEL

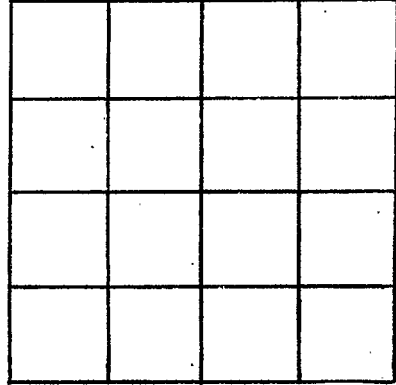

SECTION \_\_\_\_\_

Please indicate well location X.

ADDITIONAL INFORMATION

If more than one screen, show locations of each on sketch.