

MISSISSIPPI DEPARTMENT OF NATURAL RESOURCES

Bureau of Land and Water Resources

Southport Mall

P.O. Box 10631

Jackson, Mississippi 39209

WATER WELL DRILLERS LOG

Griner Drilling Service, Inc.

Lincoln

CODED

Q47
Lincoln
9-12-83

9-12-83
date well completed

Griner Drilling Service, Inc.
firm name

Lincoln
county well located

LANDOWNER:	description of formations encountered	from	to
Marion Drilling P.O. Box 3027 Daphne, Alabama (mailing address)	sand, gravel	0	105
	chalk	105	336
	sand	336	399
WELL LOCATION: 990' S + 2036' E sec. 32 T 50 N R 8 E NW/4 no. 1 road Gerard et al K. Bass Summitt miles (direction) of (nearest town)			
WELL PURPOSE: oilfield supply (home, irrigation, municipal, industrial)			
WELL COMPLETION DATA:			
(1) diameter (inches) 3"			
(2) total depth (feet) 399'			
(3) static water level (feet) 80' below top of ground.			
(4) casing steel 399' (material), (depth) 3" (size) if telescope see back.			
(5) screen 42' 357' (length), (depth to top) 3" perforated (size), (material)			
(6) pump — 70-75 (HP), (yield gpm) AC (type power)			
(7) electric log — (yes or no) — (organization running log)			
(8) how well bottom plugged orange peel			
DRILLERS REMARKS:			

CODED


DEPT. OF NATURAL RESOURCES
BUREAU OF LAND & WATER RESOURCES

OCT 3 1983

RECEIVED

If well telescopes please sketch and show depths.

GROUND LEVEL

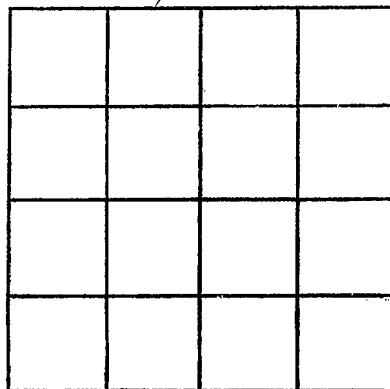

SECTION _____

Please indicate well location X.

ADDITIONAL INFORMATION

If more than one screen, show locations of each on sketch.