

MISSISSIPPI DEPARTMENT OF NATURAL RESOURCES

Bureau of Land and Water Resources

Southport Mall

P.O. Box 10631

Jackson, Mississippi 39209

WATER WELL DRILLERS LOG

Q48
Lincoln
3-14-84

CODED

Griner Drilling Service, INC.

Lincoln

3-14-84 date well completed

Griner Drilling Service, INC. firm name

Lincoln county well located

LANDOWNER:

Williams Exploration
P.O. Box 4523
Lafayette, La. 70505
(mailing address)

description of formations encountered

from

to

SAND, gravel

0 105

CLAY

105 560

SAND

560 650

CLAY

650 657

WELL LOCATION:

2100'S + 2000'W

sec 17 T. 5 N

R. 8 E NE COR

2 miles Bogue Chitto
Brewer (direction) of (nearest town)

WELL PURPOSE: oilfield supply
(home, irrigation, municipal, industrial)

WELL COMPLETION DATA:

- (1) diameter (inches) 3"
- (2) total depth (feet) 650'
- (3) static water level (feet) 200' (below top of ground)
- (4) casing steel 630' (material) (depth)
3" (size) if telescope see back.
- (5) screen 42' 588' (length) (depth to top)
3" perforated (size) (material)
- (6) pump - 70 (HP) (yield gpm)
AC (type power)
- (7) electric log (yes or no)

Drilled two wells on location - information same on both water wells

(organization running log)

(8) how well bottom plugged Orange peel

DRILLERS REMARKS:

DEPT. OF NATURAL RESOURCES
BUREAU OF LAND & WATER RESOURCES


MAR 29 1984

RECEIVED

SECT

If well telescopes please
sketch and show depths.

GROUND LEVEL

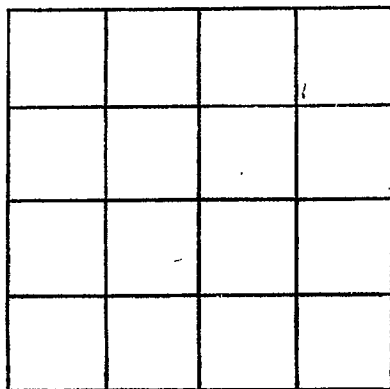

SECTION _____

Please indicate well location X.

ADDITIONAL INFORMATION

If more than one screen,
show locations of each on sketch.