

MISSISSIPPI DEPARTMENT OF NATURAL RESOURCES

Bureau of Land and Water Resources

Southport Mall

P.O. Box 10631

Jackson, Mississippi 39209

CODED

WATER WELL DRILLERS LOG

Griner Drilling Service, Inc.

Lincoln

Lincoln
Q 49
3/14/84

date well completed

firm name

county well located

LANDOWNER:

Williams Exploration
500 Cover Blvd.
P.O. Box 4523

description of formations encountered

from

to

sand, gravel

0

105

Lafayette mailing address *90502*

clay

CODED

105

560

WELL LOCATION: *2100'S + 9000'W*

sec. *17* T. *5* N. R. *8* E of

SAND

580

650

No. 1 Ames Bogue Chitto
Ames Bogue (direction) of (nearest town)

650

WELL PURPOSE: *oilfield supply*
(home, irrigation, municipal, industrial)

WELL COMPLETION DATA:

(1) diameter (inches) *3"*

(2) total depth (feet) *650'*

(3) static water level (feet) *200'* **below** above top of ground.

(4) casing *Steel*, *650'*
(material) (depth)

3"
(size) if telescope see back.

(5) screen *42'*, *608'*
(length) (depth to top)

3", *perforated*
(size) (material)

(6) pump *—*, *70*
(HP) (yield gpm)

AC
(type power)

(7) electric log *—*
(yes or no)

(organization running log)

(8) how well bottom plugged *orange*

peel

DRILLERS REMARKS:


DEPT. OF NATURAL RESOURCES
BUREAU OF LAND & WATER RESOURCES

MAY -7 1984

RECEIVED

If well telescopes please
sketch and show depths.

GROUND LEVEL

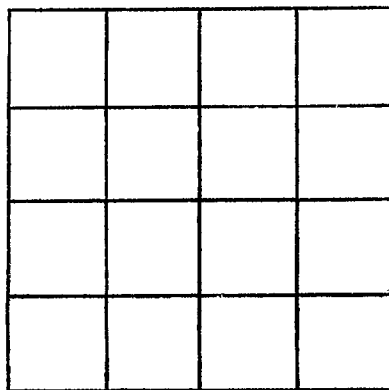

SECTION _____

Please indicate well location X.

ADDITIONAL INFORMATION

If more than one screen,
show locations of each on sketch.