

MISSISSIPPI DEPARTMENT OF NATURAL RESOURCES

Bureau of Land and Water Resources

Southport Mall

P.O. Box 10631

Jackson, Mississippi 39209

WATER WELL DRILLERS LOG

CODED

Lincoln
Q 50
3/14/84
3-14-84

Griner Drilling Service, Inc.

Lincoln

date well completed

firm name

county well located

LANDOWNER:

Marion Drilling
P.O. Box 3027
Daphne, ALA 32505
(mailing address)

description of formations encountered

from

to

SAND, gravel

0 105

CLAY

105 560

WELL LOCATION: 200'S + 2000'W

sec. 17 T. 5(N) R. 8(E) NE1/4

SAND

560 630

No. 1
Amos Brewer Bogue, Chitto
(distance) miles (direction) of (nearest town)

WELL PURPOSE: oilfield supply
(home, irrigation, municipal, industrial)

WELL COMPLETION DATA:

- (1) diameter (inches) 3"
- (2) total depth (feet) 630'
- (3) static water level (feet) 200' below top of ground.
- (4) casing Steel, 630' (material) (depth)
3" (size) if telescope see back.
- (5) screen 42' 588' (length) (depth to top)
3" perforated (size) (material)
- (6) pump — 65 (HP) (yield gpm)
AC (type power)
- (7) electric log — (yes or no)
(organization running log)

(8) how well bottom plugged orange peel

DRILLERS REMARKS:


DEPT. OF NATURAL RESOURCES
BUREAU OF LAND & WATER RESOURCES

MAY -7 1984

RECEIVED

If well telescopes please sketch and show depths.

GROUND LEVEL

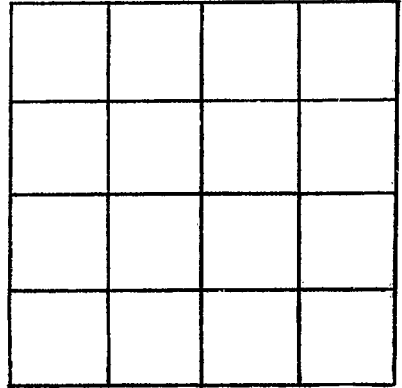

SECTION _____

Please indicate well location X.

ADDITIONAL INFORMATION

If more than one screen,
show locations of each on sketch.