

MISSISSIPPI DEPARTMENT OF NATURAL RESOURCES

Bureau of Land and Water Resources

Southport Mall

P.O. Box 10631

Jackson, Mississippi 39209

WATER WELL DRILLERS LOG

Griner Drilling Service, Inc.

CODED ✓

Lincoln

Lincoln  
Q 51  
1/16/85

1-16-85 date well completed

Griner Drilling Service, Inc. firm name

Lincoln county well located

LANDOWNER:

McMoran Exploration  
P.O. Box 6800  
Metairie, La. 70009  
(mailing address)

description of formations encountered

from

to

streaked sand & gravel 0 147  
clay 147 273

WELL LOCATION: 965'S + 2313' W

sec. 14 T. 5 N R. 8 E of No. 1 Clifton

K. Hilton et ux Ruth (distance) (direction) (nearest town)

streaked sand 273 294  
clay, rod 294 318

WELL PURPOSE: oilfield supply (home, irrigation, municipal, industrial)

sand, pea gravel 318 378  
hard clay 378 399

WELL COMPLETION DATA:

- (1) diameter (inches) 4"
- (2) total depth (feet) 399'
- (3) static water level (feet) 70' below top of ground.
- (4) casing steel 378' (material) (depth)  
4" (size) if telescope see back.
- (5) screen 42' 336' (length) (depth to top)  
4" perforated (size) (material)
- (6) pump 75 (HP) (yield gpm)  
AC (type power)
- (7) electric log (yes or no) (organization running log)

CODED

RECEIVED  
JAN 24 1985


(8) how well bottom plugged orange peel

DRILLERS REMARKS:

Department of Natural Resources  
Bureau of Land & Water Resources

If well telescopes please sketch and show depths.

GROUND LEVEL

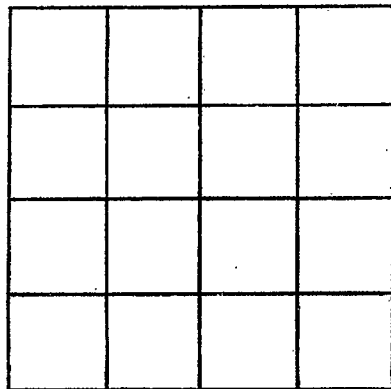

SECTION \_\_\_\_\_

Please indicate well location X.

ADDITIONAL INFORMATION

If more than one screen, show locations of each on sketch.