

LINCOLN

Q 52

MISSISSIPPI DEPARTMENT OF NATURAL RESOURCES

Bureau of Land and Water Resources

Southport Mall

P.O. Box 10631

Jackson, Mississippi 39209

WATER WELL DRILLERS LOG

CODED

Oct. 25

1984

Grenn Water Well

Lincoln

date well completed

firm name

county well located

LANDOWNER: Veta Grace Tyne

Rt. 2, Box 263

Bogue Chitto, Ms.

(mailing address)

description of formations encountered

Citronelle

from

to

1

103

WELL LOCATION:

sec. 2 T 5 N R 8 E W

5 miles E of Bogue Chitto

(distance) (direction) (nearest town)

WELL PURPOSE: home

(home, irrigation, municipal, industrial)

WELL COMPLETION DATA:

- (1) diameter (inches) 4
- (2) total depth (feet) 103
- (3) static water level (feet) 57 below above top of ground.

- (4) casing PVC 93 (material) (depth) 4" (size) if telescope see back.

- (5) screen 10' 93 (length) (depth to top) .010 PVC (size) (material)

- (6) pump did not install (HP) (yield gpm)

(type power)

- (7) electric log no (yes or no)

(organization running log)

- (8) how well bottom plugged back wash valve

CODED


RECEIVED APR 17 1985

Department of Natural Resources Bureau of Land & Water Resources

DRILLERS REMARKS:

If well telescopes please  
sketch and show depths.

GROUND LEVEL

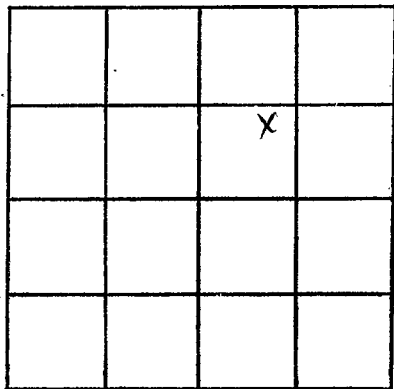

SECTION 2

Please indicate well location X.

ADDITIONAL INFORMATION

If more than one screen,  
show locations of each on sketch.