

MISSISSIPPI DEPARTMENT OF NATURAL RESOURCES

Bureau of Land and Water Resources

Southport Mall

P.O. Box 10631

Jackson, Mississippi 39209

WATER WELL DRILLERS LOG

CODED

Lincoln
Q53
5/16/85

5-16-85 Griner Drilling Service, Inc.

LINCOLN

date well completed

firm name

county well located

LANDOWNER:

See Land Drilling Co
900 Dunn Street
Houma, La. 70360
(mailing address)

description of formations encountered

from

to

sand, gravel

0 105

clay

105 336

CODED

sand

336 441

WELL LOCATION: 500' S x 330' E

sec. 19 T. 50 N. R. 8 E of

No. 1 miles N of Brewer Norfield

WELL PURPOSE: oilfield supply
(home, irrigation, municipal, industrial)

WELL COMPLETION DATA:

- (1) diameter (inches) 3"
- (2) total depth (feet) 441'
- (3) static water level (feet) 70' below top of ground.
- (4) casing steel 441' (material) (depth)
- 3" (size) if telescope see back.
- (5) screen 42' 399' (length) (depth to top)
- 3" perforated (size) (material)
- (6) pump - 80 (HP) (yield gpm)
- AC (type power)
- (7) electric log (yes or no)
- (organization running log)
- (8) how well bottom plugged orange peel

RECEIVED


JUN -4 1985

DRILLERS REMARKS:

Department of Natural Resources
Bureau of Land & Water Resources

If well telescopes please sketch and show depths.

GROUND LEVEL

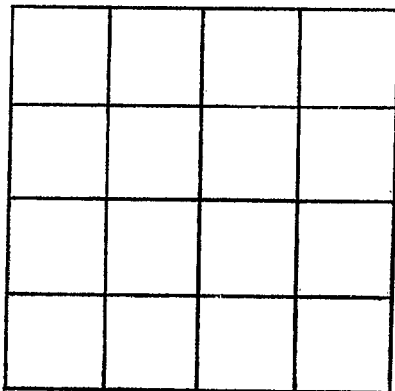

SECTION _____

Please indicate well location X.

ADDITIONAL INFORMATION

If more than one screen,
show locations of each on sketch.