

LINCOLN
 Q 54

MISSISSIPPI DEPARTMENT OF NATURAL RESOURCES
 Bureau of Land and Water Resources
 Southport Mall
 P.O. Box 10631
 Jackson, Mississippi 39209
WATER WELL DRILLERS LOG

CODED

July 26 1986 James Williams Lincoln
 date well completed firm name county well located

LANDOWNER:
Shady Grove Church
Rt Ruth
 (mailing address)

WELL LOCATION:
 sec 36 T 5 N R 8 E
3 miles W.S.W of Ruth
 (distance) (direction) (nearest town)


WELL PURPOSE: church
 (home, irrigation, municipal, industrial)

- WELL COMPLETION DATA:
- (1) diameter (inches) 4"
 - (2) total depth (feet) 330
 - (3) static water level (feet) 50 below above top of ground.
 - (4) casing plastic, bottom
 (material) (depth)
1 if telescope see back.
 (size)
 - (5) screen 10, 320'
 (length) (depth to top)
4", plastic
 (size) (material)
 - (6) pump 1/2 sub 10
 (HP) (yield gpm)
chest
 (type power)
 - (7) electric log no
 (yes or no)

 (organization running log)
 - (8) how well bottom plugged back with

description of formations encountered	from	to
<u>clay</u>	<u>0</u>	<u>17</u>
<u>clay & gravel</u>	<u>17</u>	<u>40</u>
<u>sand & gravel</u>	<u>40</u>	<u>55</u>
<u>hard blue clay</u>	<u>55</u>	<u>99</u>
<u>coarse sand</u>	<u>99</u>	<u>330</u>
(well seal to clay)		

CODED

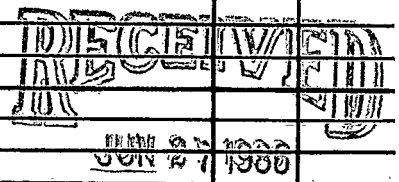

Department of Natural Resources
 Bureau of Land & Water Resources

DRILLERS REMARKS:
Top water @ 50 ft
(salty)

If well telescopes please sketch and show depths.

GROUND LEVEL

			X

SECTION 36

Please indicate well location X.

ADDITIONAL INFORMATION

If more than one screen,
show locations of each on sketch.