

# State Well Report

## Part 1 - Driller's Log

Mississippi Department of Environmental Quality  
Office of Land and Water Resources  
P.O. Box 2309  
Jackson, MS 39225  
(601)961- 5210  
(601)961- 5228 (fax)

County: Lincoln  
Permit #: \_\_\_\_\_  
Driller: Fitzgerald Well Serv  
Date drilling completed: 12-1-10

For Office Use Only:  
Aquifer: \_\_\_\_\_  
Well #: Q-72  
L. S. Elevation: \_\_\_\_\_  
E-log #: \_\_\_\_\_

**State Law requires that this report be prepared by the license holder responsible for the work and filed with the Department at the above address within 30 days of completion of drilling of the well or borehole.**

Information on Well Owner (Landowner if borehole is not for a water well)	Well or Borehole Location
Owner Name: <u>Tom Dawes</u>	Latitude: <u>31° 21' 35.2"</u> Longitude: <u>90° 26' 24.8"</u>
Mailing Address: <u>Jolimar Lane</u>	Method of Lat/Long (circle one): Conventional Survey,
<u>Rogachke MS</u>	USGS quad, Hand-held GPS, Survey-grade GPS
City State Zip Code	<u>42 1/4 NW 1/4 Sec 31 Twn 5N Rng 8E</u>
Telephone No. ( )	SE NW Distance Direction Nearest Town Miles of

**Well / Borehole Data**

Date drilling started: 12-1-10 Date drilling completed: 12-1-10 Hole depth: 109 Hole diameter: 8"

Location of the source of any surface water used for drilling: \_\_\_\_\_  
Method of dosing and volume of Chlorine used in drilling and development: \_\_\_\_\_

Logs run (circle all applicable): No log run Electric Gamma Ray Density Sonic Neutron Other: \_\_\_\_\_  
Name of organization running log(s): \_\_\_\_\_

Purpose of borehole (check one): Water Well  Geotechnical/Geological Investigation \_\_\_\_\_ Ground Source Heat Pump \_\_\_\_\_  
Seismic Survey \_\_\_\_\_ Other (describe) \_\_\_\_\_

**If drilling is not related to water well construction, skip the remainder of this block**

Purpose of Well (check one): Home  Industrial \_\_\_\_\_ Public Supply \_\_\_\_\_ Irrigation \_\_\_\_\_ Fish Culture \_\_\_\_\_ Other: \_\_\_\_\_

If a flowing well, method of flow regulation: Valve \_\_\_\_\_ Other (describe) \_\_\_\_\_

Static Water Level: 56' feet above or below (circle one) land surface Date measured: 12-1-10

Method of Measurement (circle one) steel tape electric tape air line other: \_\_\_\_\_

Well depth: 109' Well grouted to a depth of 10' feet Type of grout (circle one) Neat Cement Bentonite Mix

Casing length: 99' feet Casing diameter: 4" inches Type of casing: PVC

Screen length: 10' feet Screen diameter: 4" inches Type of screen: PVC

Screen slot size: .010 inches Setting depth: From 99' feet to 109' feet

Type of completion (circle all applicable): gravel packed Underreamed Telescoped Open hole Natural Development  
Other (describe): \_\_\_\_\_

Top of lap pipe or reduction in casing: \_\_\_\_\_ feet. **If telescoped or more than one screen, describe on next page**

Form: OLWR-SWR-1A (04/08)

RECEIVED

DEC 21 2010

BY: OLWR


Q72

The sketch below only required for water wells

Description of formations encountered must be provided for all wells and boreholes, unless specifically exempted by regulations

If well telescopes, show depths on sketch.


Ground Level →

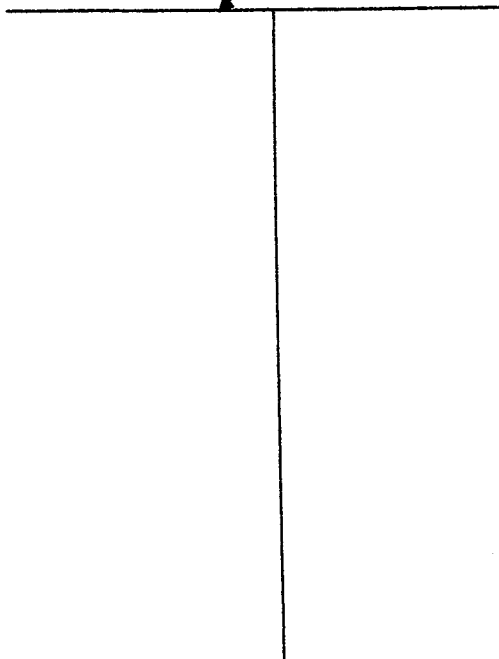

Description of Formations Encountered	From (depth)	To (depth)
	Ground Level	
clay	0	20
sand	20	60
clay	60	80
sand	80	90
Coarse Sand	90	109

If more than one screen, show location of each on sketch

Sketch the property layout and include the following: 1) the well location; 2) any permanent structures on the property that may aid in locating the well; 3) any roads, power lines, or other items that may aid in locating the property and the well; 4) a north arrow.

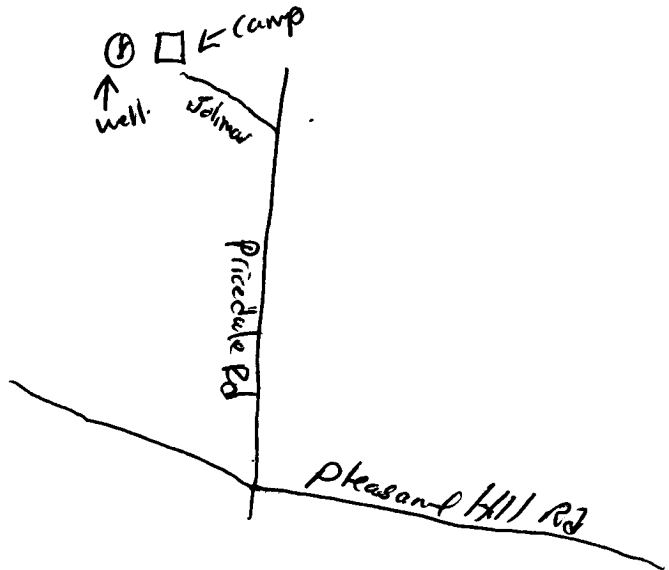

Landowner Name: Tom Davies

Form: OLWR-SWR-1A (04/08)

I certify that the well/borehole was drilled, constructed, and completed in accordance with all applicable requirements of the Mississippi Department of Environmental Quality and the Mississippi Department of Health regulations, if applicable, and state laws.

Brad Fitzgerald      026      12-1-10      Brad Fitzgerald  
 Print Name of Responsible Licensee and License No.      Date      Signature of Licensee

**RECEIVED**  
 DEC 21 2010  
 BY: OLWR

# STATE WELL REPORT

## Part 2

**Pump Installer's Completion Report**  
 Mississippi Department of Environmental Quality  
 Office of Land and Water Resources  
 P.O. Box 2309  
 Jackson, MS 39225  
 (601)961-5210  
 (601)961-5228 (fax)

For Office Use Only:

Aquifer: Q 72  
 Well #: \_\_\_\_\_  
 Elevation: \_\_\_\_\_

County: Leflore  
 Permit #: \_\_\_\_\_  
 Driller: Fitzgerald Well Serv  
 Date completed: 12-1-10  
*Copy information from block on Part 1*

*This part of the report must be completed by a licensed water well contractor or a licensed pump installer. A copy of Part 1 of the report must be attached and both parts filed with the Department at the above address within 30 days of well completion.*

Well Owner Information	Well Location
Owner Name: <u>Tom Davies</u>	Latitude: <u>31° 21' 35.2"</u> Longitude: <u>90° 26' 24.8"</u>
Mailing Address: <u>Jelmor Dr.</u>	Method of Lat/Long (check one): Conventional Survey _____
<u>Bozackton ms</u>	USGS quad _____, Hand-held GPS _____, Survey-grade GPS _____
City State Zip Code	<u>SE 1/4 NW 1/4 Sec 31 T. 5N R. 8E</u>
Telephone No. ( ) _____	Distance _____ Miles Direction _____ of Nearest Town _____

Pump Type Circle one	Power Type Circle one
Air Lift <input type="checkbox"/> Jet <input type="checkbox"/> <b>Submersible</b> <input checked="" type="checkbox"/>	Diesel Engine <input type="checkbox"/> Gasoline Engine <input type="checkbox"/> Natural Gas <input type="checkbox"/>
Bucket <input type="checkbox"/> Piston <input type="checkbox"/> Turbine <input type="checkbox"/>	<b>Electric Motor</b> <input checked="" type="checkbox"/> Hand <input type="checkbox"/> Tractor PTO <input type="checkbox"/>
Centrifugal <input type="checkbox"/> Rotary <input type="checkbox"/> Flowing Well <input type="checkbox"/>	Windmill <input type="checkbox"/> Other (specify): _____
Other (specify): _____	Horse Power Rating of Motor: <u>1/2</u>
Date Pump Installed: <u>12-1-10</u>	Setting Depth: <u>90'</u> feet
Rated Pump Capacity: <u>12</u> Gallons Per Minute	Number of Stages: <u>8</u>

Pump Test Data	Method of Measuring Water Level Circle one
Date Well Tested: _____	Air Line <input type="checkbox"/> Electric Measuring Line <input type="checkbox"/> <b>Steel Tap</b> <input checked="" type="checkbox"/>
Static Water Level (A): _____ Feet Below Land Surface	Other (specify): _____
Pumping Water Level (B): _____ Feet Below Land Surface	For flowing well, measured shut in head: _____ feet
Drawdown [(B) - (A)]: _____ Feet Below Land Surface	Well yielded _____ GPM with a drawdown of _____ feet after _____ hours of pumping
Test Pumping Rate: _____ Gallons Per Minute	
Duration of Pump Test (minimum 4 hours): _____ hours	

This is for (circle one): **New Well**  Replacement of Existing Pump  Repair of Existing Pump

I HEREBY CERTIFY that the above statements are true to the best of my knowledge.

Brian Fitzgerald Red Hill  
 Print Name of Pump Installer and License No. (if applicable) Signature of Pump Installer

**RECEIVED**

Form: OLWR-SWR-1C (07-09)

DEC 21 2010  
 BY: OLWR