
			Rollins#1				
<i>7</i> .	State We	Il Report					
County: Lincoln	Par		For Office Use Only:				
County: Miss	sissippi Department o	of Environmental Quality	Aquifer: <u>Q 73</u>				
Permit #:	Office of Land and	Water Resources	Well #:				
Driller: Gary Rayborn	P.O. Bo Jackson, MS		L. S. Elevation:				
1-1-2011	(601)96		L. S. Elevation:				
Date drilling completed:	(601)354-		E-log #:				
State Law requires that this report be prepared by the driller in detail and filed with the Department within							
30 days of completion of drilling of th Well Owner Information		Well	Location				
Owner Name D+D Drillin	g Inc	Latitude: 31 • 22 · 50	" Longitude: <u>90 ° 22 ' 3 "</u>				
Mailing Address: P. O. BOX	1634	Method of Lat/Long (circle or	ne): Conventional Survey,				
			I GPS, Survey-grade GPS				
Freedoula	71334	NTN 165, 16 Sec 23	3 Twn 5N Rng BE				
Ferriday LA City State	Zin Code	SNI					
Telephone No. 318 757-32	274	Distance Direction	of <u>Summit</u>				
Telephone No. (<u></u>)							
	Well Da		Pic al				
Purpose of Well (circle one) Home Industria	al Public Supply	Irrigation Fish Culture	Other: <u>Rig Supp</u> ly				
Date well drilling started: $1 - 7 - 20$	Dil Date w	ell drilling completed:	1-7-2011				
If flowing method of flow regulation: Valve	Other (de	scribe)					
If flowing, method of flow regulation: Valve Other (describe) Static Water Level: feet above on below (circle one) land surface Date measured: I - 7 - 2011							
Method of Measurement (circle one) steel tape electric tape air line other:							
Hole depth: <u>130'</u> Well depth: <u>130'</u> Well grouted to a depth of <u>10</u> feet							
Casing length: 100 feet Casing diameter: 4 inches Type of casing: PVC Screen length: 30 feet Screen diameter: 4 inches Type of screen: PVC							
Screen sion size:	Setting depth: From						
	·····						
l and and the			creen, describe on back of page				
Logs run (circle all applicables: No log run Electric Gamma Ray Density Sonic Neutron Other:							
Name of organization running log(s): I certify that the well was drilled, constructed	ed, and completed in a	ccordance with all applicabl	le requirements of the Mississippi				
Department of Environmental Quality and/o	or the Mississippi Dep	artment of Health regulation	ns and state laws.				
RAYDORN DRILLING, INC.	• •						
	0-60	terrent state and the second state of the seco	<u> </u>				
Print Name of Water Well Contractor and Lice	ense No.	Signature	of Water Well Contract RECEIVED				
			IAN 1 0 0044				
	•		JAN 1 3 2011				
			BY: OLWR				

3Y:	OL	.WR

If well telescopes please sketch below and show depths.



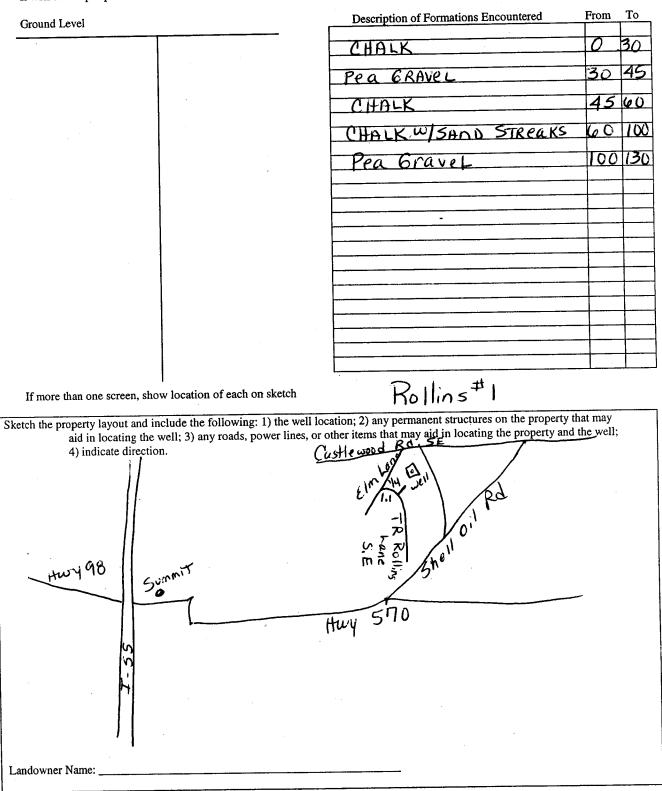

Signature of Water Well Contractor

RECEIVED 'JAN 1 3 2011 BY: OLWR

, * ,				
D.		LL REPORT	Rollins #1	
		rt 2	For Office Use Only:	
County: Lincoln	Pump Installer's Mississippi Department	Aquifer		
Permit #:	Mississippi Department Office of Land ar	Aquifer:		
Driller: Gary Rayborn	P.O. B	Well #:		
		S 39289-0631 061-5210		
Date completed: <u>1-7-2011</u>		-6938 (fax)	Elevation:	
This report should be prepared by th	e pump installer in detail	and filed with the Departme	ent within 30 days of the	
installation of pump.			Il Location	
Well Owner Informat				
Owner Name: D+D Dr.	Iling Inc	Latitude:	Longitude:	
Mailing Address: P. D. Box	1634	Method of Lat/Long (circle one): Conventional Survey,		
		USGS quad, Han	d-held GPS, Survey-grade GPS	
Ferriday La 71334 City State Zip Code		1414 Sec 23 Twn 5N Rng 8E		
		Distance Direction Nearest Town		
Telephone No. (318) 757 - 3274		10,8 Miles NE of SUMMIT		
	······································			
Pump Type	· · · · · · · · · · · · · · · · · · ·	P	ower Type	
Circle one			Circle one	
Air Lift Jet 🤇	Submersible	Diesel Engine Gasol	line Engine Natural Gas	
Bucket Piston	Turbine	Electric Motor Hand	I Tractor PTO	
Centrifugal Rotary	Flowing Well	Windmill Othe	r (specify):	
Other (specify):		Horse Power Rating of Moto	or: <u>5 HP</u>	
	Date Pump Installed: $1 - 7 - 2011$		105' feet	
			11	
Rated Pump Capacity:	Gallons Per Minute	Number of Stages:	<u></u>	
Denne Track Data		Method of N	Aeasuring Water Level	
Pump Test Data			Circle one	
Date Well Tested:	-2 UII	Ain Line Therein 14	(easuring Line) Steel Tape	
Static Water Level (A):Feet Below Land Surface		Air Line Electric Measuring Line Steel Tape Other (specify):		
Pumping Water Level (B):Fee	t Below Land Surface	Other (specify):		
Drawdown [(B) – (A)]:Fea		For flowing well, measured	shut in head:feet	
Test Pumping Rate: 60		Well vielded	GPM with a drawdown of	
Duration of Pump Test (minimum 4 hours		feet after	rhours of pumping	
[· · · · · · · · · · · · · · · · · · ·	
I HEREBY CERTIFY that the above state	ements are true to the best	of my knowledge.	`	
Gary Kayborn	0-60		DEPEN	
Print Name of Pump Installer and License	e No. (if applicable)	Signature of Pur	Installer NEUEI	
			14A1 1 2 (

JAN	1	3	2 011
BY:	()L	.WR

11