

Lincoln

Franklin
Q 2000
8-12-75


MISSISSIPPI
BOARD OF WATER COMMISSIONERS
416 North State Street
Jackson, Mississippi 39201

WATER WELL DRILLERS LOG

Lincoln
Franklin

August 12 1975 Grenn Water Well Cont. Franklin
date well completed firm name county well located

LANDOWNER: Kenneth Reeves Route 1 Bogue Chitto, Miss. (mailing address)	description of formations encountered Citronelle	from 1	to 98
WELL LOCATION:			
sec. 15 T. 5 N. R. 8 E 13th			
4 miles SW SE of Bogue Chitto			
(distance) (direction) (nearest town)			
WELL PURPOSE: home			
(home, irrigation, municipal, industrial)			
WELL COMPLETION DATA:			
(1) diameter (inches) 6"			
(2) total depth (feet) 98'			
(3) static water level (feet) 70 below top of ground.			
(4) casing PVC, 92' (material) (depth)			
4" (size) If telescope see back.			
(5) screen 6', 92' (length) (depth to top)			
, 010 PVC (size) (material)			
(6) pump 3/4 Sub & 7 (HP) (yield gpm)			
Electricity (type power)			
(7) electric log no (yes or no)			
(organization running log)			
(8) how well bottom plugged wood			
DRILLERS REMARKS:			

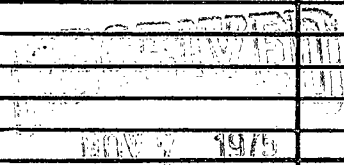

MISS. BOARD OF WATER COMMISSIONERS

If well telescopes please sketch and show depths.

GROUND LEVEL

			X

SECTION 15

Please indicate well location X.

ADDITIONAL INFORMATION

If more than one screen, show locations of each on sketch.