

Lincoln
 Q 2001
 10/21/75

MISSISSIPPI
 BOARD OF WATER COMMISSIONERS
 416 North State Street
 Jackson, Mississippi 39201

WATER WELL DRILLERS LOG


21 Oct 1975 ¹³⁴ J. T. Coyle & Son Lincoln
 date well completed firm name county well located

LANDOWNER:	description of formations encountered	from	to
Hornell Mc Clelland B. C. Mc (mailing address)			
WELL LOCATION: sec 21 T 5 N R 8 E 8 miles N of Summit (distance) (direction) (nearest town)			
WELL PURPOSE: (home, irrigation, municipal, industrial)			
WELL COMPLETION DATA:			
(1) diameter (inches) 4			
(2) total depth (feet) 80			
(3) static water level (feet) 60 below above top of ground.			
(4) casing (material) PI (depth) 74 (size) if telescope see back.			
(5) screen (length) 6 (depth to top) 74 (size) 4 (material) PI			
(6) pump (HP) 1/2 (yield gpm) 8 (type power) chert			
(7) electric log (yes or no)			
(organization running log)			
(8) how well bottom plugged <u>crud</u>			
DRILLERS REMARKS:			

RECEIVED
 DISTRICT # 10
 DEC 15 1975
 MISS. Bd. OF WATER COMMISSIONERS

If well telescopes please sketch and show depths.

GROUND LEVEL

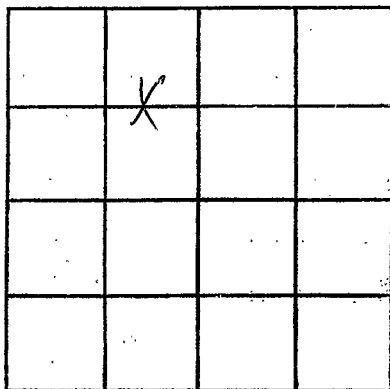

SECTION 21

Please indicate well location X.

ADDITIONAL INFORMATION

If more than one screen, show locations of each on sketch.