


Lincoln  
AO 2002  
12-4-75

MISSISSIPPI  
 BOARD OF WATER COMMISSIONERS  
 416 North State Street  
 Jackson, Mississippi 39201

WATER WELL DRILLERS LOG

Dec. 4 1975 Grenn Water Well Con. Lincoln  
 date well completed firm name county well located


LANDOWNER: Riley Price	description of formations encountered	from	to
3226 Meadow Lane	Citronelle	1	126
Jackson, Miss. 39212 (mailing address)			
<b>WELL LOCATION:</b>			
sec. 10 T 5 <u>N</u> R 8 <u>E</u>			
3 miles <u>E</u> of Bogue Chitto (distance) (direction) (nearest town)			
<b>WELL PURPOSE:</b> home (home, irrigation, municipal, industrial)			
<b>WELL COMPLETION DATA:</b>			
(1) diameter (inches) <u>4</u>			
(2) total depth (feet) <u>126</u>			
(3) static water level (feet) <u>65</u> <u>below</u> above top of ground.			
(4) casing <u>PVC</u> <u>120</u> (material) (depth) <u>no</u> if telescope see back. (size)			
(5) screen <u>6'</u> <u>120'</u> (length) (depth to top). <u>.010</u> <u>PVC</u> (size) (material)			
(6) pump <u>1/3</u> sub <u>7</u> (HP) (yield gpm) <u>electric</u> (type power)			
(7) electric log <u>no</u> (yes or no)			
(organization running log)			
(8) how well bottom plugged <u>wood</u>			
DRILLERS REMARKS:			

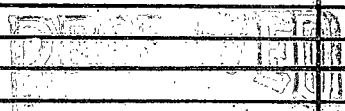

MAY 7 1976

If well telescopes please sketch and show depths.

GROUND LEVEL

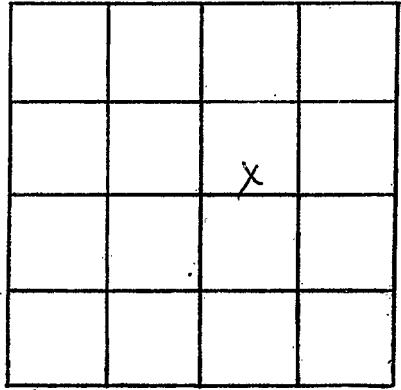

SECTION 10

Please indicate well location X.

ADDITIONAL INFORMATION

A series of horizontal lines for recording additional information, starting below the 'ADDITIONAL INFORMATION' header and extending to the bottom of the page.

If more than one screen, show locations of each on sketch.