

Lincoln
Q 2003
4-4-77

MISSISSIPPI
BOARD OF WATER COMMISSIONERS
416 North State Street
138 Jackson, Mississippi 39201

WATER WELL DRILLERS LOG

4-4-1977 date well completed
Fitzgerald Well Service firm name
Lincoln county well located

LANDOWNER:
Billy Price
R.R. Brummett
(mailing address)

WELL LOCATION:
sec. 35 T. 8 N. R. 8 E
3 miles E of Brummett
(distance) (direction) (nearest town)

WELL PURPOSE:
Home
(home, irrigation, municipal, industrial)

- WELL COMPLETION DATA:
- (1) diameter (inches) 4
 - (2) total depth (feet) 118
 - (3) static water level (feet) 70 below top of ground.
 - (4) casing PVC, 110 (material), (depth)
4 (size) if telescope see back.
 - (5) screen 8, 110 (length), (depth to top)
4 (size), PVC (material)
 - (6) pump 1/2 (HP), 110 (yield gpm)
electric (type power)
 - (7) electric log No (yes or no)
(organization running log)
 - (8) how well bottom plugged Good


description of formations encountered	from to	
Red clay	0	20
Red gravel	20	60
Red sand	60	90
Crude sand & gravel	90	118

DRILLERS REMARKS:

RECEIVED
JUL 5 - 1977

If well telescopes please sketch and show depths.

GROUND LEVEL

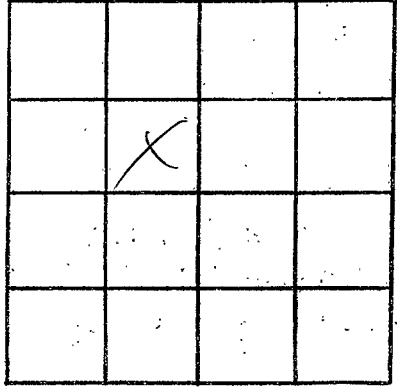

SECTION 8

Please indicate well location X.

ADDITIONAL INFORMATION

If more than one screen, show locations of each on sketch.