

Lincoln
 Q 2007
 5-17-76

MISSISSIPPI
 BOARD OF WATER COMMISSIONERS
 416 North State Street
 Jackson, Mississippi 39201

WATER WELL DRILLERS LOG

17 May 1976 date well completed
 76 John Neal Hall firm name
 Amos Parker
 Lincoln county well located

LANDOWNER:

John Neal Hall

description of formations encountered

from to

clay	0	20
shale	20	35
sand	35	65
chert	65	75
gravel	75	100

(mailing address)

WELL LOCATION:

sec. 8 T. 5 N R. 8 E
 3 miles SE of B.C.
 (distance) (direction) (nearest town)

WELL PURPOSE:

(home, irrigation, municipal, industrial)

WELL COMPLETION DATA:


- (1) diameter (inches) 4
- (2) total depth (feet) 100
- (3) static water level (feet) 70 below top of ground.
- (4) casing (material) PL (depth) 96
- 1 1/2 (size) if telescope see back.
- (5) screen 7 (length) 63 (depth to top)
- (size) (material)
- (6) pump 1/2 (HP) 8 (yield gpm)
- dist (type power)
- (7) electric log (yes or no)

(organization running log)

(8) how well bottom plugged

Wood

DRILLERS REMARKS:

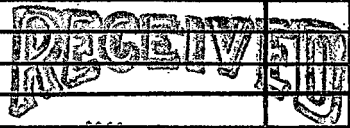


JUL 29 1976

MISS. BD. OF WATER COMMISSIONERS

If well telescopes please sketch and show depths.

GROUND LEVEL

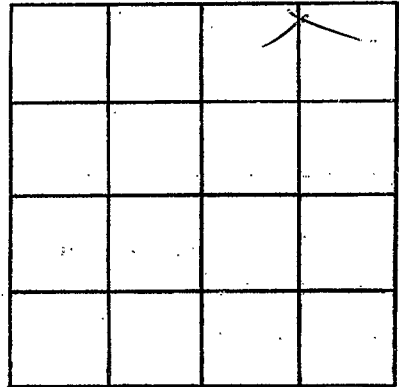

SECTION 3

Please indicate well location X.

ADDITIONAL INFORMATION

If more than one screen, show locations of each on sketch.