

Lincoln
 Q 2005
 7/19/77

MISSISSIPPI
 BOARD OF WATER COMMISSIONERS
 416 North State Street
 134 Jackson, Mississippi 39201

WATER WELL DRILLERS LOG

July 19 1977 Covington firm name Lincoln county well located

LANDOWNER: Jessie B. Price
 Bogue Chitto
 Miss.
 (mailing address)

description of formations encountered	from	to
CITY	0	12
Gravel	12	61

WELL LOCATION:
 sec. 6 T. 5 N. R. 8 E.
 2 1/2 miles E. of Bogue Chitto
 (distance) (direction) (nearest town)

WELL PURPOSE: Home
 (home, irrigation, municipal, industrial)

- WELL COMPLETION DATA:
- (1) diameter (inches) 4
 - (2) total depth (feet) 61
 - (3) static water level (feet) 49 below top of ground.
 - (4) casing (material) Plastic 51 (depth)
 4 (size) if telescope see back.
 - (5) screen 10' 51 (length) (depth to top)
 4 (size) Plastic (material)
 - (6) pump 1/2 (HP) 5 (yield gpm)
 - (type power)
 - (7) electric log (yes or no)
 - (organization running log)
 - (8) how well bottom plugged wood


DRILLERS REMARKS:

RECEIVED
 AUG 5 1977

MISS. Bd. OF WATER COMMISSIONERS

If well telescopes please sketch and show depths.

GROUND LEVEL

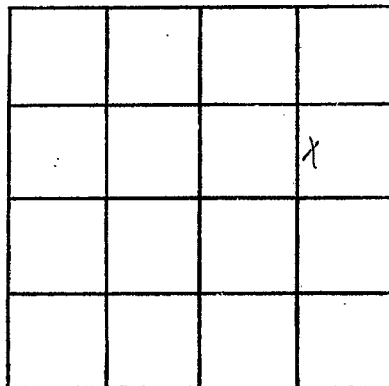

SECTION 6

Please indicate well location X.

ADDITIONAL INFORMATION

If more than one screen,
show locations of each on sketch.