

LINCOLN
 Q 2007
 3-20-78

MISSISSIPPI
 BOARD OF WATER COMMISSIONERS
 416 North State Street
 Jackson, Mississippi 39201

WATER WELL DRILLERS LOG

March 20, 1978 Reuma Well Co Lincoln
 date well completed firm name county well located

LANDOWNER: Jamie Clark
Rt Bequa Chitto
 (mailing address)

description of formations encountered

	from	to
<u>black gravel</u>	<u>0</u>	<u>20</u>
<u>sand & some gravel</u>	<u>20</u>	<u>50</u>
<u>blue chalk</u>	<u>50</u>	<u>95</u>
<u>sand & pea gravel</u>	<u>95</u>	<u>110</u>

WELL LOCATION:
 sec 18 T 5 N R 8 E
3 miles E-SE of Morfield
 (distance) (direction) (nearest town)

WELL PURPOSE: new house
 (home, irrigation, municipal, industrial)

WELL COMPLETION DATA:

(1) diameter (inches) 4"

(2) total depth (feet) 110

(3) static water level (feet) 65 below above top of ground.

(4) casing 4" plastic (material) (depth)

if telescope see back. (size)

(5) screen 5' 125' (length) (depth to top)

4" plastic (size) (material)

(6) pump by others (type power) (yield gpm)

split (type power)

(7) electric log no (yes or no)

(organization running log)

(8) how well bottom plugged
wooden plug


DRILLERS REMARKS:
[Signature]

RECEIVED
 JUN - 8 1978

MISS. BD. OF WATER COMM

If well telescopes please sketch and show depths.

GROUND LEVEL

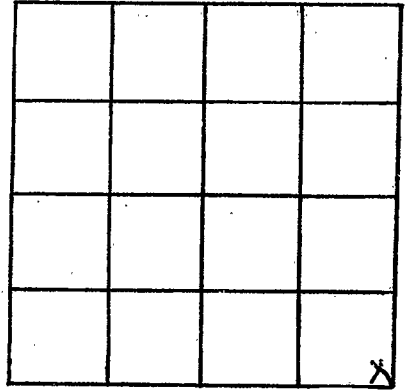

SECTION 18

Please indicate well location X.

ADDITIONAL INFORMATION

If more than one screen,
show locations of each on sketch.