

Lincoln
Q 2009
3-19-79

MISSISSIPPI
BOARD OF WATER COMMISSIONERS
416 North State Street
Jackson, Mississippi 39201

WATER WELL DRILLERS LOG

3-19 1979
date well completed

Edmund DeWitt Lewis
firm name

Lincoln
county well located

LANDOWNER:

Cliff Mook
R.R. - Bruce Clith
(mailing address)

description of formations encountered

from

to

Red clay 0 20
Red sand & chlk 20 80
Coarse sand & gravel 80 95

WELL LOCATION:

sec. 26 T 5 N R 8 E
S W
4 miles NW of Brady Bay
(distance) (direction) (nearest town)

WELL PURPOSE:

Home
(home, irrigation, municipal, industrial)

WELL COMPLETION DATA:

- (1) diameter (inches) 4
- (2) total depth (feet) 95
- (3) static water level (feet) 45 below top of ground.
- (4) casing PVC, 87 (material) (depth)
4 (size) if telescope see back.
- (5) screen 8, 87 (length) (depth to top)
4 (size) PVC (material)
- (6) pump 1/2 (HP) 10 (yield gpm)
Blue (type power)
- (7) electric log no (yes or no)

(organization running log)

(8) how well bottom plugged Seal off

Miss. Board of Water Comm.


DRILLERS REMARKS:

MAR 28 1979

RECEIVED

If well telescopes please sketch and show depths.

GROUND LEVEL

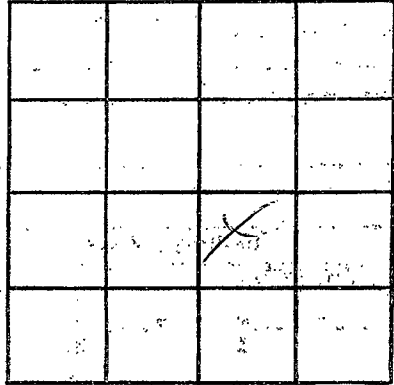

SECTION 26

Please indicate well location X.

ADDITIONAL INFORMATION

Multiple horizontal lines for writing additional information.

If more than one screen, show locations of each on sketch.