

Lincoln
Q 2010
5-18-79

MISSISSIPPI
 BOARD OF WATER COMMISSIONERS
 416 North State Street
 Jackson, Mississippi 39201

WATER WELL DRILLERS LOG


May 18 1979 Grenn Water Well Cont. Lincoln
 date well completed firm name county well located

LANDOWNER:	description of formations encountered	from	to
Floyd Boone Route 1, Box 180 Bogue Chitto, Miss. (mailing address)	Citronelle	1	128
WELL LOCATION:			
sec. <u>10</u> T. <u>5</u> <u>N</u> R. <u>8</u> <u>E</u> 4 miles SE of Bogue Chitto (distance) (direction) (nearest town)			
WELL PURPOSE: home (home, irrigation, municipal, industrial)			
WELL COMPLETION DATA:			
(1) diameter (inches) <u>4</u>			
(2) total depth (feet) <u>128</u>			
(3) static water level (feet) <u>55</u> below top of ground. above			
(4) casing <u>PVC</u> <u>116</u> (material) (depth) <u>4"</u> (size) if telescope see back.			
(5) screen <u>12'</u> <u>116'</u> (length) (depth to top) <u>.010</u> <u>PVC</u> (size) (material)			
(6) pump <u>1/2 HP</u> <u>Sub</u> <u>10</u> (HP) (yield gpm) <u>electricity</u> (type power)			
(7) electric log <u>no</u> (yes or no) (organization running log)			
(8) how well bottom plugged <u>back wash valve</u>			
DRILLERS REMARKS:			

Miss. Board of Water Comm.
 JUL 9 1979
 RECEIVED

If well telescopes please sketch and show depths.

GROUND LEVEL

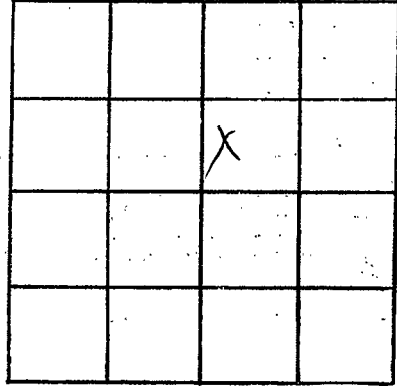

SECTION 10

Please indicate well location X.

ADDITIONAL INFORMATION

If more than one screen,
show locations of each on sketch.