


Lincoln
Q 2013
6-15-81

MISSISSIPPI
BOARD OF WATER COMMISSIONERS
416 North State Street
Jackson, Mississippi 39201

WATER WELL DRILLERS LOG


6-15 1981 Stewart & McCall Lincoln
date well completed firm name county well located

LANDOWNER:	description of formations encountered	from	to
<u>Sharon McCallough</u>	<u>Red clay</u>	0	20
<u>R.R. Ruth Mrs.</u> (mailing address)	<u>Red sand</u>	20	95
	<u>limestone</u>	95	109
WELL LOCATION:			
sec. <u>36</u> T <u>5</u> N R <u>8</u> E S W			
<u>1</u> miles <u>N</u> of <u>Geokly</u> (distance) (direction) (nearest town)			
WELL PURPOSE: <u>Home</u> (home, irrigation, municipal, industrial)			
WELL COMPLETION DATA:			
(1) diameter (inches) <u>4</u>			
(2) total depth (feet) <u>109</u>			
(3) static water level (feet) <u>45</u> below top of ground.			
(4) casing <u>PVC</u> , <u>101</u> , (material) (depth)			
<u>4</u> (size) if telescope see back.			
(5) screen <u>8</u> , <u>101</u> (length) (depth to top)			
<u>4</u> , <u>PVC</u> (size) (material)			
(6) pump <u>1/2</u> , <u>10</u> (HP) (yield gpm)			
<u>EL</u> (type power)			
(7) electric log <u>no</u> (yes or no)			
(organization running log)			
(8) how well bottom plugged <u>Seal</u>			
DRILLERS REMARKS:			

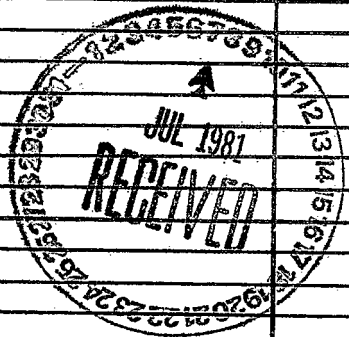

If well telescopes please sketch and show depths.

GROUND LEVEL

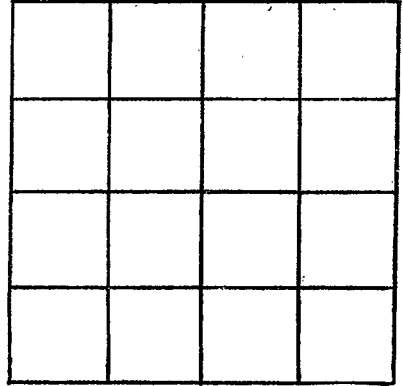

SECTION _____

Please indicate well location X.

ADDITIONAL INFORMATION

If more than one screen, show locations of each on sketch.