

MISSISSIPPI DEPARTMENT OF NATURAL RESOURCES

Bureau of Land and Water Resources

Southport Mall

P.O. Box 10631

Jackson, Mississippi 39209

WATER WELL DRILLERS LOG

Lincoln
Q2014
6-9-81

June 9 1981 Grenn Water Wel, Contractor Lincoln
date well completed firm name county well located

LANDOWNER: Howard Mercier

Rt. 2, Box 212

Bogue Chitto, Ms.

(mailing address)

description of formations encountered

Citronelle

from

to

1

80

WELL LOCATION:

sec. 32 T 5 N R 8 E
S W

2 miles E of Bogue Chitto
(distance) (direction) (nearest town)

WELL PURPOSE: home
(home, irrigation, municipal, industrial)

WELL COMPLETION DATA:

- (1) diameter (inches) 4
- (2) total depth (feet) 80
- (3) static water level (feet) 47 below above top of ground.

(4) casing PVC 70'
(material) (depth)
4"
(size) if telescope see back.

(5) screen 10' 70'
(length) (depth to top)
.010 PVC
(size) (material)

(6) pump did not install
(HP) (yield gpm)


(type power)

(7) electric log no
(yes or no)

(organization running log)


(8) how well bottom plugged back was h valve

DRILLERS REMARKS:

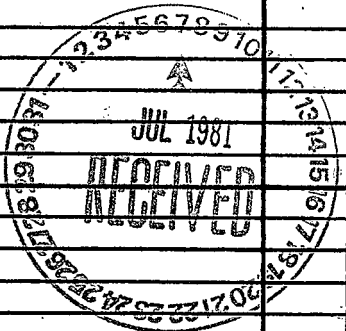

If well telescopes please sketch and show depths.

GROUND LEVEL

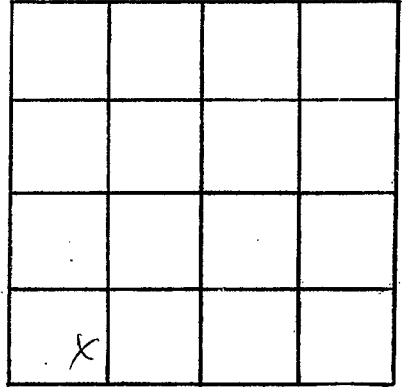

SECTION 32

Please indicate well location X.

ADDITIONAL INFORMATION

If more than one screen,
show locations of each on sketch.