


Lincoln
Q 2015
6-18-81

MISSISSIPPI DEPARTMENT OF NATURAL RESOURCES
 Bureau of Land and Water Resources
 Southport Mall
 P.O. Box 10631
 Jackson, Mississippi 39209
WATER WELL DRILLERS LOG

June 18 1981 Grenn Water Well Cont. Lincoln
 date well completed firm name county well located

LANDOWNER: <u>Lloyd Wallace</u>	description of formations encountered	from	to
<u>Route 3, Box 220 A</u>			
<u>Bogue Chitto, Ms.</u> (mailing address)			
WELL LOCATION: sec. <u>10</u> T <u>5</u> N R <u>8</u> E S W <u>3</u> miles <u>SE</u> of <u>Bogue Chitto</u> (distance) (direction) (nearest town)			
WELL PURPOSE: <u>home</u> (home, irrigation, municipal, industrial)			
WELL COMPLETION DATA:			
(1) diameter (inches) <u>4</u>			
(2) total depth (feet) <u>130</u>			
(3) static water level (feet) <u>70</u> below top of ground.			
(4) casing <u>PVC</u> <u>120'</u> (material) (depth) <u>.010</u> (size) if telescope see back.			
(5) screen <u>10'</u> <u>120'</u> (length) (depth to top) <u>.060</u> <u>PVC</u> (size) (material)			
(6) pump <u>did not install</u> (HP) (yield gpm) (type power)			
(7) electric log <u>no</u> (yes or no) (organization running log)			
(8) how well bottom plugged <u>back wash valve</u>			
DRILLERS REMARKS:			

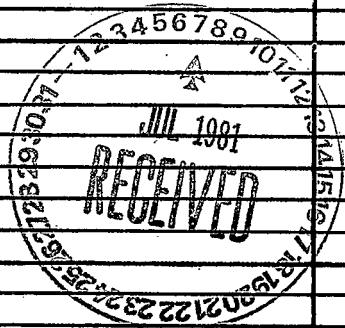

If well telescopes please sketch and show depths.

GROUND LEVEL

X			

SECTION 10

Please indicate well location X.

ADDITIONAL INFORMATION

If more than one screen, show locations of each on sketch.