

Lincoln
 Q 2016
 8-31-81

MISSISSIPPI
 BOARD OF WATER COMMISSIONERS
 416 North State Street
 Jackson, Mississippi 39201

WATER WELL DRILLERS LOG

8-31-81 date well completed
 19 Brumfield Well serv firm name
 Lincoln county well located

LANDOWNER: Robert Hodges
 Rt. 1
 Bogue Chitto ms.
 (mailing address)

WELL LOCATION:
 sec. 24 T-5 N R-8 E
 2.5 miles WNW of Ruth
 (distance) (direction) (nearest town)

WELL PURPOSE: home
 (home, irrigation, municipal, industrial)

WELL COMPLETION DATA:
 (1) diameter (inches) 4"
 (2) total depth (feet) 90
 (3) static water level (feet) 62' below above of ground.
 (4) casing PVC 80' (material) (depth)
 4' if telescope see back. (size)
 (5) screen 10' 80' (length) (depth to top)
 4" PVC (size) (material)
 (6) pump 1/2 Sub 10 (HP) (yield gpm)
 Electric (type power)
 (7) electric log no. (yes or no).
 (organization running log)
 (8) how well bottom plugged SAND SHANK


description of formations encountered	from	to
Yellow CLAY	0	15
SAND & CLAY	15	44
SAND + GRAVEL	44	55
CHALK	55	62
SAND	62	78
SAND + Pea Gravel	78	90

DRILLERS REMARKS:

DEPT. OF NATURAL RESOURCES
 BUREAU OF LAND & WATER RESOURCES
 SEP 17 1981
 RECEIVED

If well telescopes please sketch and show depths.

GROUND LEVEL

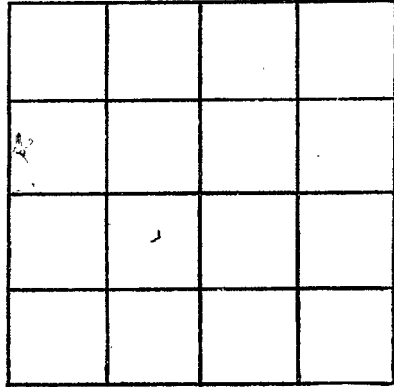

SECTION 24

Please indicate well location X.

ADDITIONAL INFORMATION

Lined area for providing additional information.

If more than one screen, show locations of each on sketch.