

Lincoln
 Q 2019
 11-6-81

MISSISSIPPI
 BOARD OF WATER COMMISSIONERS
 416 North State Street
 Jackson, Mississippi 39201

WATER WELL DRILLERS LOG

11-6-81
 date well completed

1981 *Fitzgerald Well Service*
 firm name

Lincoln
 county well located

LANDOWNER:	description of formations encountered	from	to
<i>Kris Jordan</i>			
<i>P.B. Bogue Clifton</i> (mailing address)	<i>Red Clay</i> <i>Red Sand</i> <i>Coarse Sand & gravel</i>	<i>0</i> <i>20</i> <i>90</i>	<i>20</i> <i>90</i> <i>105</i>
WELL LOCATION:			
sec. <i>25</i> T. <i>5</i> N. R. <i>8</i> E. S. W.			
<i>1</i> miles <i>NW</i> of <i>Stock, Ga.</i> (distance) (direction) (nearest town)			
WELL PURPOSE: <i>Home</i> (home, irrigation, municipal, industrial)			
WELL COMPLETION DATA:			
(1) diameter (inches) <i>4</i>			
(2) total depth (feet) <i>108</i>			
(3) static water level (feet) <i>65</i> below top of ground.			
(4) casing <i>PVC</i> <i>100</i> (material) (depth)			
<i>4</i> if telescope see back. (size)			
(5) screen <i>8</i> <i>100</i> (length) (depth to top)			
<i>4</i> <i>PVC</i> (size) (material)			
(6) pump <i>1/2</i> <i>10</i> (HP) (yield gpm)			
<i>Electric</i> (type power)			
(7) electric log <i>No</i> (yes or no)			
(organization running log)			
(8) how well bottom plugged <i>Sealed</i>			
DRILLERS REMARKS:			


DEPT. OF NATURAL RESOURCES
 BUREAU OF LAND & WATER RESOURCES

NOV 20 1981

RECEIVED

If well telescopes please sketch and show depths.

GROUND LEVEL

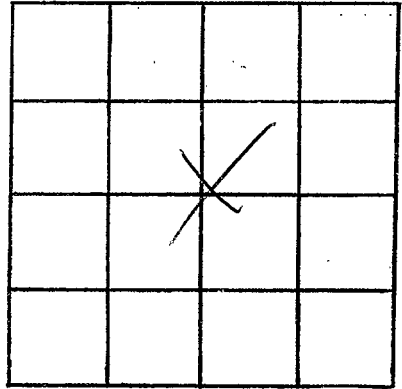

SECTION 25

Please indicate well location X.

ADDITIONAL INFORMATION

If more than one screen, show locations of each on sketch.