

Lincoln
Q
2021

MISSISSIPPI
BOARD OF WATER COMMISSIONERS
416 North State Street
Jackson, Mississippi 39201

WATER WELL DRILLERS LOG

12-10 date well completed 19 81 firm name Fitzgerald Well Dr. Lincoln county well located

LANDOWNER:	description of formations encountered	from	to
Alton Boyce	Reel clay	0	20
R.R. Summit Ms. (mailing address)	Reel sand & clay	20	105
	Coarse sand & gravel	105	118
WELL LOCATION:			
sec. 34 T 5 N R 8 E S W			
5 miles NE of JOHNSON STATION (distance) (direction) (nearest town)			
WELL PURPOSE: Home (home, irrigation, municipal, industrial)			
WELL COMPLETION DATA:			
(1) diameter (inches) 4			
(2) total depth (feet) 118			
(3) static water level (feet) 50 below top of ground.			
(4) casing PVC, 110 (material) (depth)			
4 (size) if telescope see back.			
(5) screen 8, 110 (length) (depth to top)			
4, PVC (size) (material)			
(6) pump 1/2, 70 (HP) (yield gpm)			
Elev (type power)			
(7) electric log re (yes of no)			
(organization running log)			
(8) how well bottom plugged Seal Plug			
DRILLERS REMARKS:			


DEPT. OF NATURAL RESOURCES
BUREAU OF LAND & WATER RESOURCES

JAN 15 1982

RECEIVED

If well telescopes please sketch and show depths.

GROUND LEVEL

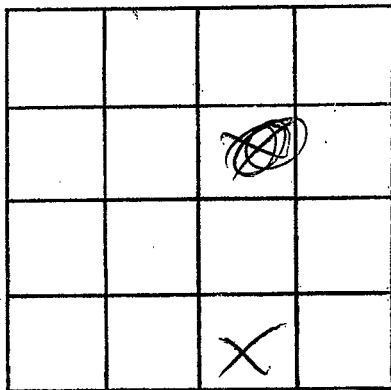

SECTION 34

Please indicate well location X.

ADDITIONAL INFORMATION

If more than one screen, show locations of each on sketch.