

Linder  
Q  
2022

MISSISSIPPI  
 BOARD OF WATER COMMISSIONERS

DEPT. OF NATURAL RESOURCES  
 BUREAU OF LAND & WATER RESOURCES

416 North State Street

Jackson, Mississippi 39201

MAR 22 1982

WATER WELL DRILLERS LOG

RECEIVED

Feb. 25 19 82  
 date well completed

Bramfield Well Serv. Co. in con  
 firm name

county well located

LANDOWNER: J. H. HALL  
Route # 3  
Boque Chocta Miss  
 (mailing address)

description of formations encountered	from	to
Top Soil + Clay	0	9
SANDY CLAY	9	38
SAND	38	40
Blue CLAY	40	66
SAND ROCK	66	67
SAND	67	80

WELL LOCATION:  
 sec. 17 T 5 N R 8 E  
3 miles S.E. of Boque Chocta  
 (distance) (direction) (nearest town)


WELL PURPOSE: Home  
 (home, irrigation, municipal, industrial)

- WELL COMPLETION DATA:
- (1) diameter (inches) 4
  - (2) total depth (feet) 80
  - (3) static water level (feet) 45 below top of ground.
  - (4) casing Plastic 70  
 (material) (depth)  
4" if telescope see back.  
 (size)
  - (5) screen 10' 70'  
 (length) (depth to top)  
4" Plastic  
 (size) (material)
  - (6) pump 1/2 Sub 8  
 (HP) (yield gpm)  
Electric  
 (type power)
  - (7) electric log \_\_\_\_\_  
 (yes or no)
  - \_\_\_\_\_  
 (organization running log)
  - (8) how well bottom plugged Sand Shank

DRILLERS REMARKS:

If well telescopes please sketch and show depths.

GROUND LEVEL

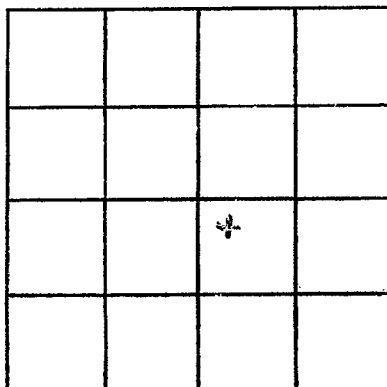

SECTION 17

Please indicate well location X.

ADDITIONAL INFORMATION

If more than one screen,  
show locations of each on sketch.