

Lincoln
Q
2033

MISSISSIPPI DEPARTMENT OF NATURAL RESOURCES
Bureau of Land and Water Resources
Southport Mall
P.O. Box 10631
Jackson, Mississippi 39209
WATER WELL DRILLERS LOG

Apr. 16 19 82 Grenn Water Well Lincoln
date well completed firm name county well located

LANDOWNER: James Mercier Rt. 1, Box 9A Bogue Chitto, Ms. (mailing address)	description of formations encountered Citronelle	from 1	to 76
WELL LOCATION:			
sec. <u>6</u> T. <u>5</u> N R. <u>8</u> E S W			
<u>1</u> miles East of Bogue Chitto (distance) (direction) (nearest town)			
WELL PURPOSE: home (home, irrigation, municipal, industrial)			
WELL COMPLETION DATA:			
(1) diameter (inches) <u>4</u>			
(2) total depth (feet) <u>76</u>			
(3) static water level (feet) <u>49</u> below above top of ground.			
(4) casing <u>PVC</u> <u>66'</u> (material) (depth) <u>4"</u> (size) if telescope see back.			
(5) screen <u>10'</u> <u>66'</u> (length) (depth to top) <u>.010</u> <u>PVC</u> (size) (material)			
(6) pump <u>did not install</u> (HP) (yield gpm) (type power)			
(7) electric log <u>no</u> (yes or no) (organization running log)			
(8) how well bottom plugged <u>back wash valve</u>			

DEPT. OF NATURAL RESOURCES
BUREAU OF LAND & WATER RESOURCES


JUN 14 1982

RECEIVED

DRILLERS REMARKS:

If well telescopes please sketch and show depths.

GROUND LEVEL

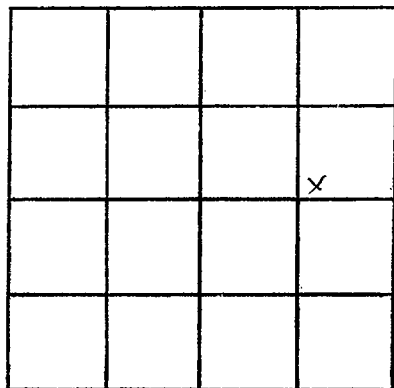

SECTION 6

Please indicate well location X.

ADDITIONAL INFORMATION

If more than one screen,
show locations of each on sketch.