

Lincoln
Q 2024

MISSISSIPPI
 BOARD OF WATER COMMISSIONERS
 416 North State Street
 Jackson, Mississippi 39201

WATER WELL DRILLERS LOG

7-1 19*82* *Ft. Snell Well Service Lincoln*
 date well completed firm name county well located

LANDOWNER:	description of formations encountered	from	to
<i>Deborah Dickerson</i>			
<i>R.R. Ruth Ms.</i> (mailing address)	<i>Buildup</i>	<i>0</i>	<i>20</i>
WELL LOCATION:	<i>Buildup</i>	<i>20</i>	<i>40</i>
sec. <i>25</i> T <i>5</i> N R. <i>8</i> E	<i>Real Chalk & sand</i>	<i>40</i>	<i>110</i>
<i>7</i> miles <i>NE</i> of <i>Sumit</i> (distance) (direction) (nearest town)	<i>Coarse sand & gravel</i>	<i>110</i>	<i>120</i>
WELL PURPOSE: <i>Flow</i> (home, irrigation, municipal, industrial)			
WELL COMPLETION DATA:			
(1) diameter (inches) <i>4</i>			
(2) total depth (feet) <i>120</i>			
(3) static water level (feet) <i>4</i> below top of ground.			
(4) casing <i>PVC</i> , <i>112</i> , (material) (depth)			
<i>4</i> if telescope see back. (size)			
(5) screen <i>8</i> , <i>112</i> (length) (depth to top)			
<i>4</i> , <i>PVC</i> (size) (material)			
(6) pump <i>1/2</i> , <i>10</i> (HP) (yield gpm)			
<i>Ele</i> (type power)			
(7) electric log <i>no</i> (yes or no)			
(organization running log)			
(8) how well bottom plugged <i>Full</i>			
DRILLERS REMARKS:			


DEPT. OF NATURAL RESOURCES
 BUREAU OF LAND & WATER RESOURCES

JUL - 7 1982

RECEIVED

If well telescopes please sketch and show depths.

GROUND LEVEL

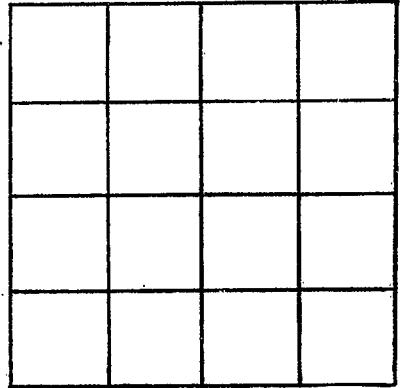

SECTION _____

Please indicate well location X.

ADDITIONAL INFORMATION

If more than one screen, show locations of each on sketch.