

MISSISSIPPI DEPARTMENT OF NATURAL RESOURCES

Bureau of Land and Water Resources

Southport Mall

P.O. Box 10631

Jackson, Mississippi 39209

WATER WELL DRILLERS LOG

Lincoln  
Q  
2025

2-24 1982 Acme Well Co Lincoln  
 date well completed firm name county well located

LANDOWNER:	description of formations encountered	from	to
<u>Parcell Thomas</u> <u>St Summit</u> (mailing address)			
WELL LOCATION: sec. <u>17</u> T. <u>5</u> N R. <u>8</u> E <u>2</u> miles <u>north</u> of <u>Moada Creek Church</u> (distance) (direction) (nearest town)			
WELL PURPOSE: <u>Trails</u> (home, irrigation, municipal, industrial)			
WELL COMPLETION DATA:			
(1) diameter (inches) <u>4"</u>			
(2) total depth (feet) <u>114</u>			
(3) static water level (feet) <u>81</u> below top of ground.			
(4) casing <u>plastic, bottom</u> (material) (depth)			
<u>          </u> if telescope see back. (size)			
(5) screen <u>5'</u> <u>109'</u> (length) (depth to top)			
<u>4"</u> <u>plastic</u> (size) (material)			
(6) pump <u>shel</u> <u>12</u> (HP) (yield gpm)			
<u>shel</u> (type power)			
(7) electric log <u>no</u> (yes or no)			
<u>          </u> (organization running log)			
(8) how well bottom plugged <u>both wash</u>			
DRILLERS REMARKS:			


DEPT. OF NATURAL RESOURCES  
 BUREAU OF LAND & WATER RESOURCES

JUL 15 1982

RECEIVED

If well telescopes please  
sketch and show depths.

GROUND LEVEL

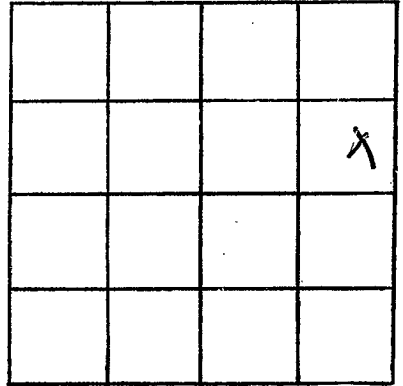

SECTION 17

Please indicate well location X.

ADDITIONAL INFORMATION

If more than one screen,  
show locations of each on sketch.