

MISSISSIPPI DEPARTMENT OF NATURAL RESOURCES
Bureau of Land and Water Resources
 Southport Mall
 P.O. Box 10631
 Jackson, Mississippi 39209
WATER WELL DRILLERS LOG

Lincoln
Q
2027

June 2 19 82 Gremn Water Well Lincoln
 date well completed firm name county well located


LANDOWNER:	description of fomations encountered	from	to
Riley Price			
3226 Meadow Lane	Citronelle	1	127
Jackson, Ms. (mailing address)			
WELL LOCATION: sec. <u>10</u> T <u>5</u> N R <u>8</u> E S W <u>4</u> miles SE of Bogue Chitto (distance) (direction) (nearest town)			
WELL PURPOSE: home (home, irrigation, municipal, industrial)			
WELL COMPLETION DATA:			
(1) diameter (inches) <u>4</u>			
(2) total depth (feet) <u>127</u>			
(3) static water level (feet) <u>60</u> below top of ground.			
(4) casing <u>PVC</u> , <u>117'</u> (material) (depth) <u>4"</u> (size) if telescope see back.			
(5) screen <u>10'</u> , <u>117'</u> (length) (depth to top) <u>.010</u> , <u>PVC</u> (size) (material)			
(6) pump <u>did not install</u> (HP) (yield gpm) (type power)			
(7) electric log <u>no</u> (yes or no) (organization running log)			
(8) how well bottom plugged, <u>back wash valve</u>			

DEPT. OF NATURAL RESOURCES
 BUREAU OF LAND & WATER RESOURCES
 AUG 20 1982
RECEIVED

DRILLERS REMARKS:

If well telescopes please sketch and show depths.

GROUND LEVEL

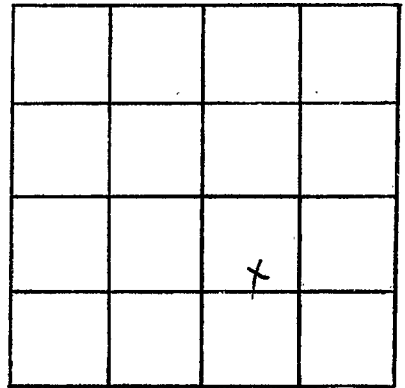

SECTION 10

Please indicate well location X.

ADDITIONAL INFORMATION

If more than one screen, show locations of each on sketch.