

Lincoln
Q
2028

MISSISSIPPI
 BOARD OF WATER COMMISSIONERS
 416 North State Street
 Jackson, Mississippi 39201

WATER WELL DRILLERS LOG

Sept. 21 1982
 date well completed

81 Bramfield Well Serv
 firm name

Lincoln
 county well located

LANDOWNER: Tony Porter

RE # 1

Boyer Chitto gms
 (mailing address)

WELL LOCATION:

sec. 3 T 5 N R 8 E
4 miles E of Boyer Chitto
 (distance) (direction) (nearest town)

WELL PURPOSE: Home
 (home, irrigation, municipal, industrial)

WELL COMPLETION DATA:

- (1) diameter (inches) 4"
- (2) total depth (feet) 90'
- (3) static water level (feet) 45' below above top of ground.
- (4) casing Plastic 80'
 (material) (depth)
4" if telescope see back.
 (size)
- (5) screen 10' 80'
 (length) (depth to top)
4" Plastic
 (size) (material)
- (6) pump 3/4 Set 4
 (HP) (yield gpm)
Electric
 (type power)
- (7) electric log 910
 (yes or no)

(organization running log)

(8) how well bottom plugged Sandstone

description of formations encountered

description of formations encountered	from	to
<u>Surf Acc 0/174</u>	<u>0</u>	<u>22</u>
<u>Sand + Clay</u>	<u>22</u>	<u>48</u>
<u>Sand + Rock</u>	<u>45</u>	<u>54</u>
<u>Sand rock</u>	<u>54</u>	<u>54 1/2</u>
<u>Loblolly</u>	<u>54 1/2</u>	<u>72</u>
<u>Red Clay</u>	<u>72</u>	<u>78</u>
<u>Sand + Rock</u>	<u>78</u>	<u>90</u>

DRILLERS REMARKS:


DEPT. OF NATURAL RESOURCES
 BUREAU OF LAND & WATER RESOURCES

SEP 29 1982

RECEIVED

If well telescopes please sketch and show depths.

GROUND LEVEL

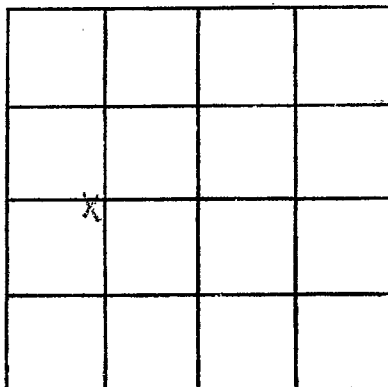

SECTION 3

Please indicate well location X.

ADDITIONAL INFORMATION

If more than one screen, show locations of each on sketch.