

MISSISSIPPI DEPARTMENT OF NATURAL RESOURCES
Bureau of Land and Water Resources
 Southport Mall
 P.O. Box 10631
 Jackson, Mississippi 39209
WATER WELL DRILLERS LOG

Lincoln
Q
2034

10-17 19 83 Grenn Water Well Lincoln
 date well completed firm name county well located

LANDOWNER: <u>Delton Brister</u> <u>Rt. 2, Box 26</u>	description of formations encountered	from	to
<u>Bogue Chitto, Ms.</u> (mailing address)	<u>Citronelle</u>	<u>1</u>	<u>127</u>
WELL LOCATION:			
sec <u>1</u> T <u>5</u> N R <u>8</u> E S W <u>6</u> miles <u>E</u> of <u>Bogue Chitto</u> (distance) (direction) (nearest town)			
WELL PURPOSE: <u>home</u> (home, irrigation, municipal, industrial)			
WELL COMPLETION DATA:			
(1) diameter (inches) <u>4</u>			
(2) total depth (feet) <u>127</u>			
(3) static water level (feet) <u>75</u> below top of ground.			
(4) casing <u>PVC</u> , <u>117'</u> (material) (depth) <u>4"</u> If telescope see back. (size)			
(5) screen <u>10'</u> , <u>117'</u> (length) (depth to top) <u>.010</u> , <u>PVC</u> (size) (material)			
(6) pump <u>did not install</u> (HP) (yield gpm) (type power)			
(7) electric log <u>no</u> (yes or no) (organization running log)			
(8) how well bottom plugged <u>back wash valve</u>			
DRILLERS REMARKS:			


DEPT. OF NATURAL RESOURCES
 BUREAU OF LAND & WATER RESOURCES

MAR - 8 1984

RECEIVED

If well telescopes please sketch and show depths.

GROUND LEVEL

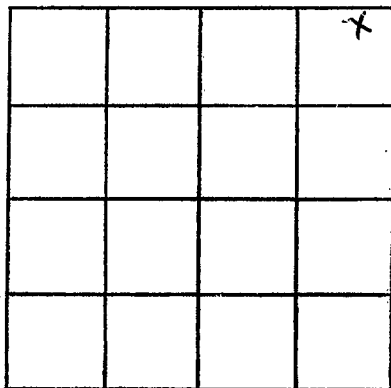

SECTION /

Please indicate well location X.

ADDITIONAL INFORMATION

If more than one screen, show locations of each on sketch.