

MISSISSIPPI DEPARTMENT OF NATURAL RESOURCES

Bureau of Land and Water Resources

Southport Mall

P.O. Box 106318

Jackson, Mississippi 39209

WATER WELL DRILLERS LOG

Lincoln
Q237

11-13
 date well completed

84 Fitzgerald Well Sew
 firm name

Lincoln
 county well located

LANDOWNER:
Tom Davies
R.R. Summit, Mrs.
 (mailing address)

description of formations encountered	depth	
	from	to
<i>Red clay</i>	<i>0</i>	<i>20</i>
<i>Red sand</i>	<i>20</i>	<i>90</i>
<i>Coarse sand & gravel</i>	<i>90</i>	<i>112</i>

WELL LOCATION:
 sec. *35* T *5* N R *8* E
 S W
7 miles *NE* of *Summit*
 (distance) (direction) (nearest town)

WELL PURPOSE: *Home*
 (home, irrigation, municipal, industrial)

- WELL COMPLETION DATA:
- (1) diameter (inches) *4*
 - (2) total depth (feet) *112*
 - (3) static water level (feet) *55* below top of ground.
 - (4) casing *PVC 104*,
 (material) (depth)
4 If telescope see back.
 (size)
 - (5) screen *8*, *104*
 (length) (depth to top)
4, *PVC*
 (size) (material)
 - (6) pump *1/2*, *10*
 (HP) (yield gpm)
elec
 (type power)
 - (7) electric log *no*
 (yes or no)
 (organization running log)
 - (8) how well bottom plugged *Sand Seal*

DRILLERS REMARKS:


DEPT. OF NATURAL RESOURCES
 BUREAU OF LAND & WATER RESOURCES

DEC - 6 1984

RECEIVED

If well telescopes please sketch and show depths.

GROUND LEVEL

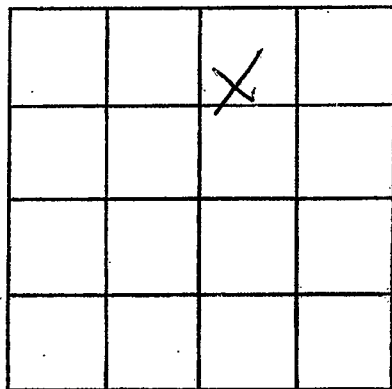

SECTION 35

Please indicate well location X.

ADDITIONAL INFORMATION

If more than one screen,
show locations of each on sketch.