

MISSISSIPPI DEPARTMENT OF NATURAL RESOURCES

Bureau of Land and Water Resources

Southport Mall

P.O. Box 10631

Jackson, Mississippi 39209

WATER WELL DRILLERS LOG

Lincoln
Q 2038
7-12-85

L

7-12
date well completed

1985 Fitzgerald Well Sew
firm name

Lincoln
county well located

LANDOWNER:

Sonny Parker

P.R. Boggs ditto
(mailing address)

description of formations encountered

from

to

Red clay
Course sand & gravel

0 20
20 71

WELL LOCATION:

sec. 30 T 5 N R 8 E
S W
7 miles NE of Summit
(distance) (direction) (nearest town)

WELL PURPOSE:

Home
(home, irrigation, municipal, industrial)

WELL COMPLETION DATA:

- (1) diameter (inches) 4
- (2) total depth (feet) 71
- (3) static water level (feet) 45 below top of ground.
- (4) casing PVC 61
(material) (depth)
4
(size) if telescope see back.
- (5) screen 10 61
(length) (depth to top)
4
(size) PVC
(material)
- (6) pump 1/2 10
(HP) (yield gpm)
Elex
(type power)
- (7) electric log no
(yes or no)
- (8) how well bottom plugged Seal
(organization running log)


RECEIVED
JUL 25 1985

DRILLERS REMARKS:

Department of Natural Resources
Bureau of Land & Water Resources

If well telescopes please sketch and show depths.

GROUND LEVEL

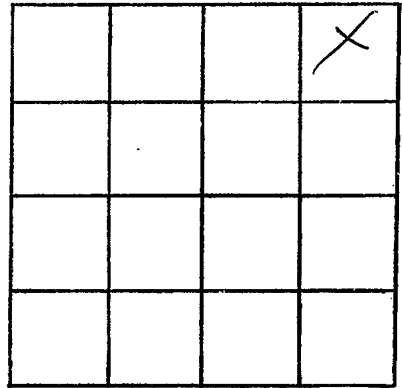

SECTION 30

Please indicate well location X.

ADDITIONAL INFORMATION

If more than one screen,
show locations of each on sketch.