

MISSISSIPPI DEPARTMENT OF NATURAL RESOURCES

Bureau of Land and Water Resources

Southport Mall

P.O. Box 10631

Jackson, Mississippi 39209

WATER WELL DRILLERS LOG

LINCOLN
Q
2039

11-6
date well completed

1985 Fitzgerald Well Serv Lincoln
firm name

Lincoln
county well located

LANDOWNER:	description of formations encountered	from	to
Julia Price			
R.R. Beauclerk (mailing address)	Red clay	0	20
	Red sand	20	90
	Coarse sand & gravel	90	120
WELL LOCATION:			
sec. 28 T 5 N R 8 E S W			
7 miles NE of Summit (distance) (direction) (nearest town)			
WELL PURPOSE: Home (home, irrigation, municipal, industrial)			
WELL COMPLETION DATA:			
(1) diameter (inches) 4			
(2) total depth (feet) 120			
(3) static water level (feet) 65 below top of ground.			
(4) casing PVC, 110 (material) (depth)			
4 if telescope see back. (size)			
(5) screen 10, 110 (length) (depth to top)			
4, PVC (size) (material)			
(6) pump 1/2, 10 (HP) (yield gpm)			
Elec (type power)			
(7) electric log no (yes or no)			
(organization running log)			
(8) how well bottom plugged sand filter			


RECEIVED
NOV 27 1985

DRILLERS REMARKS:

Department of Natural Resources
Bureau of Land & Water Resources

If well telescopes please
sketch and show depths.

GROUND LEVEL

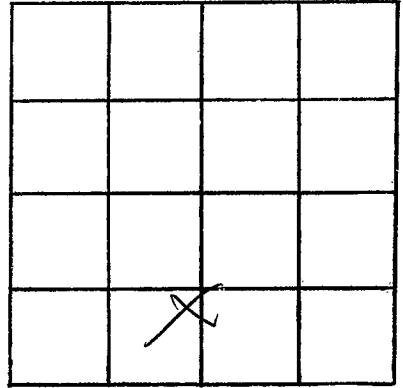

SECTION 28

Please indicate well location X.

ADDITIONAL INFORMATION

If more than one screen,
show locations of each on sketch.