

MISSISSIPPI DEPARTMENT OF NATURAL RESOURCES

Bureau of Land and Water Resources

Southport Mall

P.O. Box 10631

Jackson, Mississippi 39209

WATER WELL DRILLERS LOG

LINCOLN  
Q 2041


3-7 19 86 Grenn Water Well Lincoln  
date well completed firm name county well located

LANDOWNER: Betty Rollins	description of formations encountered	from	to
Rt. 1, Box 30	Citronelle	1	198
Bogue Chitto, Ms. (mailing address)			
WELL LOCATION: sec. 20 T N 5 R 8 E S W 3 miles SE of Bogue Chitto (distance) (direction) (nearest town)			
WELL PURPOSE: home (home, irrigation, municipal, industrial)			
WELL COMPLETION DATA:			
(1) diameter (inches) 4			
(2) total depth (feet) 108			
(3) static water level (feet) 42 below above top of ground.			
(4) casing PVC 98' (material) (depth) 4" (size) if telescope see back.			
(5) screen 10' 98' (length) (depth to top) .010 PVC (size) (material)			
(6) pump 1/2 sub 80 (HP) (yield gpm)			
electricity (type power)			
(7) electric log no (yes or no)			
(organization running log)			
(8) how well bottom plugged back wash valve			
DRILLERS REMARKS:			

APR 1 1986  
Department of Natural Resources  
Bureau of Land & Water Resources

If well telescopes please sketch and show depths.

GROUND LEVEL

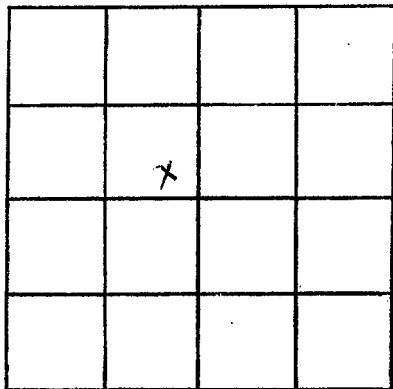

SECTION 20

Please indicate well location X.

ADDITIONAL INFORMATION

If more than one screen,  
show locations of each on sketch.